


Map No. Kansas Sec. 1 Twp. 24 R. 9
Well No. 13 Cartwright Farm
Roth-Farrish - Manhattan Company

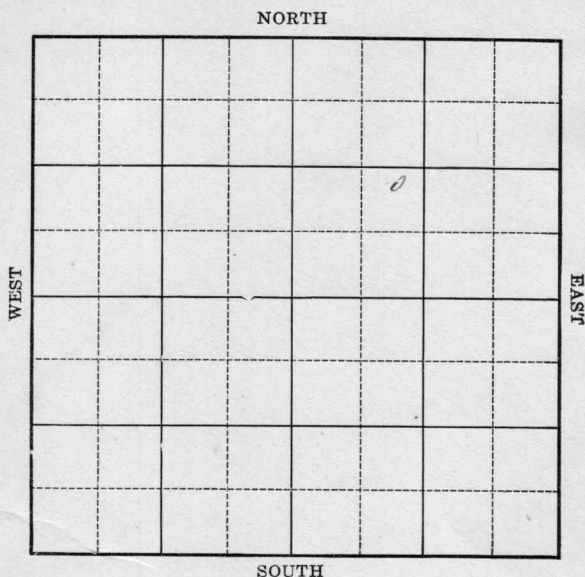

Location _____

Drilling Remarks _____

Rig Up _____

Drilling Remarks _____

RECORD


Cased _____ in. _____ ft.
Sand _____
Gas _____
Oil _____
Total Depth _____

PRODUCTION

1st 24 hrs. Nat. _____
1st 24 hrs. after shot _____
Gas _____ cu. ft.
Dry Hole _____
Abandoned _____

Map No. *Kano* Sec. *1* Twp. *24* R. *9*Well No. # *12* - *Cartwright* Farm
Roth Insurance-Markhutton Company

NORTH

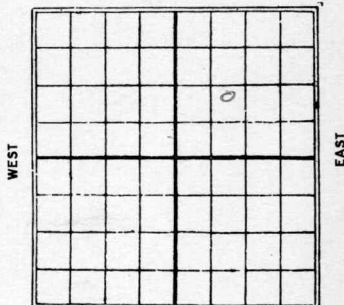

Ft. from N. Line

728 Ft. from S. Line

Ft. from E. Line

1526 Ft. from W. Line

SOUTH

1926

Date

REPORT

*5/19 Rgn**6/2 Drly 700'**6/10 " 1480'**6/18 " 2042**6/30 Sand 2263-2313**T.D. 2349 70 gals**40 bbls*

Sherwood
 K15 KANSAS
 Map No. _____ Sec. *1* Twp. *24* R. *9*
 Well No. *12 Cartwright*
Boyle-Faust & Manhattan Company

Contractor

FIRST REPORTS

SECTION PLAT

		o	

Ft. from N. Line

728

Ft. from S. Line

Ft. from E. Line

1256

Ft. from W. Line

Location ☒Rig up ☐

Drilling and Remarks:

RECORD

Cased _____ in., _____ ft.

Sand _____

Gas _____

Oil _____

Total Depth _____

PRODUCTION

1st 24 hrs. Nat. _____

1st 24 hrs. after shot _____

Gas _____ Cu. Ft.

Dry Hole _____

Abandoned _____

Date

MAY 19 1926

192

CHAS. L. SHERWOOD

Scout

K15 **KANSAS** Sec. 1 Twp. 24 R. 9
 Well No. 12 Cartwright
Booth-Laurat & Manhattan Company

Contractor

COMPLETED

SECTION PLAT

Ft. from N. Line

728

Ft. from S. Line

Ft. from E. Line

1256

Ft. from W. Line

		o	

Location

Rig up

Drilling and Remarks:

79 40 BS.

RECORD

Cased 2263-2313 in., 2313 ft.

Sand

Gas

Oil

Total Depth 2349'

PRODUCTION

1st 24 hrs. Nat. _____

1st 24 hrs. after shot _____

Gas _____ Cu. Ft.

Dry Hole _____

Abandoned _____

Date

JUN 30 1926

192

CHAS. L. SHERWOOD

Scout