

Map No.

Sec.

Twp.

R.

Well No.

Farm

Company

NORTH

WEST

EAST

SOUTH

Location

Drilling Remarks:

Rig up

Drilling Remarks:

RECORD

Cased _____ in. _____ ft.

Sand _____

Gas _____

Oil _____

Total Depth_____

PRODUCTION

1st 24 hrs Nat. _____

1st 24 hrs. after shot_____


Gas _____ cu. ft.

Dry Hole _____

Abandoned _____

Map No. K Sec. 1 Twp. 24 R. 9Well No. 1 - Hedlison Farm
Lewis Oil Company

NORTH

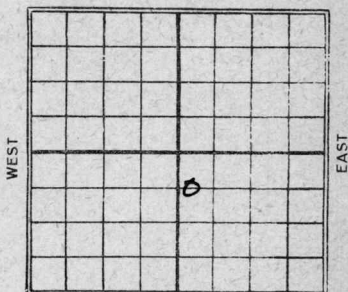

SOUTH

660 Ft. from N. Line

_____ Ft. from S. Line

_____ Ft. from E. Line

200 Ft. from W. Line

REPORT

19246/10 Qty 1350'
21457/9 2310-2337 IAP,
20/90 Bbls

15 ~~KANSAS~~
Map No. _____ Sec. _____ Twp. 24 R. 9

Well No. 1 Hedderon
Lewis oil Company

Contractor

FIRST REPORT

SECTION PLAT

660 Ft. from N. Line
____ Ft. from S. Line
____ Ft. from E. Line
200 Ft. from W. Line

		0	

Location _____
Rig up _____
Drilling and Remarks:

20.1350
2145

RECORD

Cased _____ in., _____ ft.
Sand _____
Gas _____
Oil _____
Total Depth _____

PRODUCTION

1st 24 hrs. Nat. _____
1st 24 hrs. after shot _____
Gas _____ Cu. Ft.
Dry Hole _____
Abandoned _____

Date JUN 10 1924
192 _____ Scout
M. A. BENEAR

Map No. ¹⁵ **KANSAS** Sec. 1 Twp. 24 R. 9

Well No. 1 *Huddleston*
Lewis Oil Company

Contractor

COMPLETED

SECTION PLAT

660 Ft. from N. Line

_____ Ft. from S. Line

_____ Ft. from E. Line

200 Ft. from W. Line

		0	

Location _____

Rig up _____

Drilling and Remarks:

S. 2310-2337-50

20/90 flls

RECORD

Cased _____ in., _____ ft.

Sand _____

Gas _____

Oil _____

Total Depth _____

PRODUCTION

1st 24 hrs. Nat. _____

1st 24 hrs. after shot _____

Gas _____ Cu. Ft.

Dry Hole _____

Abandoned _____

Date

JUL 9 1924

192

M. A. BENEAR

Scout