


Map No. 1 Kans Sec. 1 Twp. 34 R. 19
 Well No. 4 Heddleson Farm
Lewis + National Company

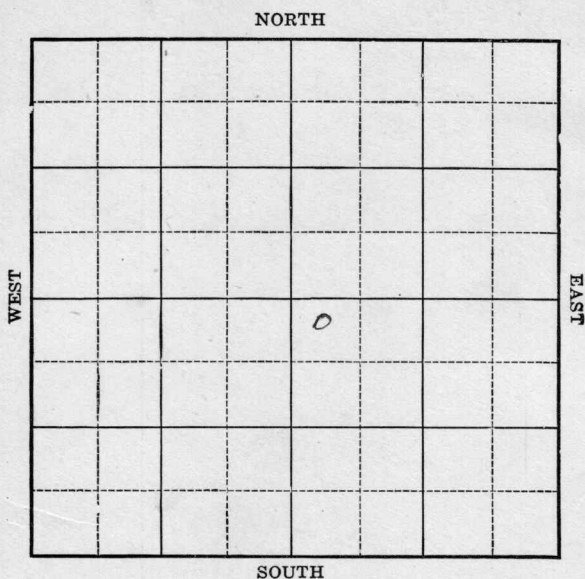

Location _____

Drilling Remarks

RECORD

Cased _____ in. _____ ft.

Sand _____

Gas _____

Oil _____

Total Depth _____

Rig Up _____

Drilling Remarks

PRODUCTION

1st 24 hrs. Nat. _____

1st. 24 hrs. after shot _____

Gas _____ cu. ft.


Dry Hole _____

Abandoned _____

Map No. Kansas Sec. 1 Twp. 24 R. 9Well No. 4 Heddeson FarmLewis & National Company200 Ft. from N. Line

Ft. from S. Line

Ft. from E. Line

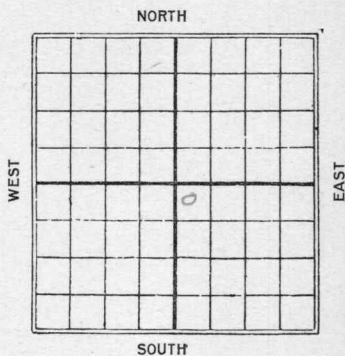300 Ft. from W. Line

Date

REPORT

19253/24Rgn up5/82300 - 2335 130 gtl75 Bbls

15
 Map No. **KANSAS** Sec. 1 Twp. 24 R. 9

 Well No. 4 Heddleson
Lewis & National Company

Contractor

FIRST REPORT

SECTION PLAT

200 Ft. from N. Line

_____ Ft. from S. Line

_____ Ft. from E. Line

200 Ft. from W. Line

		0	

Location _____

Rig up _____

Drilling and Remarks:

Rig up

RECORD

Cased _____ in., _____ ft.

Sand _____

Gas _____

Oil _____

Total Depth _____

PRODUCTION

1st 24 hrs. Nat. _____

1st 24 hrs. after shot _____

Gas _____ Cu. Ft.

Dry Hole _____

Abandoned _____

Date

3/24 1925

M. A. BENEAR

Scout

Map No. 15 Kinds Sec. 1 Twp. 24 R. 9Well No. 4 AcademyLewis & Co. & National Company

Contractor

SECTION PLAT

200 Ft. from N. Line

Ft. from S. Line

Ft. from E. Line

200 Ft. from W. Line

COMPLETED

		0	

Location

Rig up

Drilling and Remarks:

RECORD

Cased _____ in., _____ ft.

Sand 2300-2335'

Gas _____

Oil _____

Total Depth _____

PRODUCTION

1st 24 hrs. Nat. _____

1st 24 hrs. after shot _____

Gas _____ Cu. Ft.

Dry Hole _____

Abandoned _____

Date

MAY 8 1925

192

CHAS. L. SHERWOOD

Scout