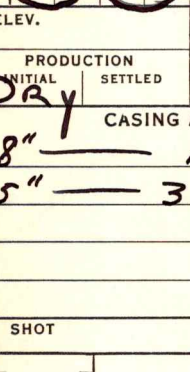


Texas Co.

STATE KANSAS		COMPANY E.F. Moran	
COUNTY Stefford		FARM Max Sittner #2	WELL NO. #2
T. 21S	R. 12W	DIVISION	DISTRICT
SURVEY		KIND OF RIG	
		COMMENCED 6-4-41	
		COMPLETED 6-30-41	
		REMARKS	
ELEV.			
PRODUCTION INITIAL DRY SETTLED			

CASING AND SCREEN RECORD

8" ————— 196'

5" ————— 3595'

