


Map No. 1 Sec. 1 Twp. 09 R. 7

Well No. 2. The Ellison Farm

Company

NORTH

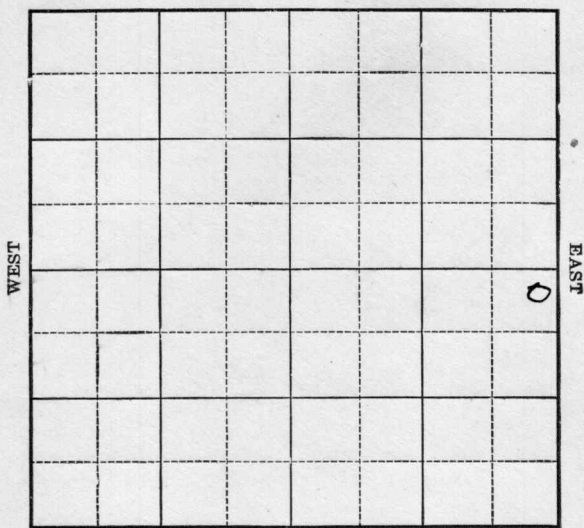

SOUTH

Location _____

Drilling Remarks:

Rig Up _____

Drilling Remarks:

RECORD

Cased_____ in._____ft.

Sand _____

Gas _____

Oil_____

Total Depth

PRODUCTION

1st 24 hrs. Nat. _____

1st 24 hrs. after shot_____

Gas _____ cu. ft.

Dry Hole _____


Abandoned _____

Map No. 15 Sec. 1 Twp. 24 R. 9Well No. 2 - Hedden Farm
Lewis & National Company200 Ft. from N. Line

Ft. from S. Line

200 Ft. from E. Line

Ft. from W. Line

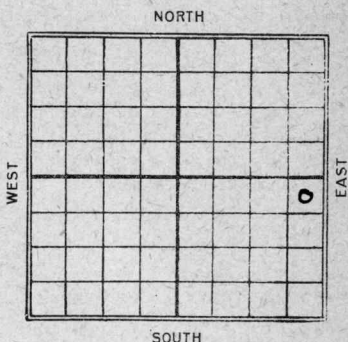

1924

REPORT

6/10 Broken sand - 2275
2356 -
A 14. 2358

Well No. 2 Madison

Lewis & National Company

----- Contractor

SECTION PLAT

200 **ABANDONED**
Ft. from N. Line

Ft. from S. Line

200 Ft. from E. Line

Ft. from W. Line

RECORD

Location -----

Rig up -----

Drilling and Remarks:

LO. 1225

Broken s. $\frac{2}{3}$

2079

2350

Cased-----in., ----- ft.

Sand -----

Gas -----

Oil-----

Total Depth-----

PRODUCTION

1st 24 hrs. Nat. _____

1st 24 hrs. after shot-----

Gas-----Cu. Ft.

Dry Hole-----

Abandoned-----

Date _____

JUN 10 1924

192

M. A. BENEAR

Scout