

Map No. 71 Sec. 1 Twp. 24 R. 9
Well No. 5 Marshall Farm
Ark Huel Company

NORTH

WEST

EAST

SOUTH

Location _____

Drilling Remarks:

Rig up _____

Drilling Remarks:

RECORD

Cased _____ in. _____ ft.

Sand _____

Gas _____

Oil _____

Total Depth_____

PRODUCTION

1st 24 hrs Nat. _____

1st 24 hrs. after shot_____

Gas _____ cu. ft.

Dry Hole _____

Abandoned _____

Map No. K Sec. 1 Twp. 24 R. 9Well No. 5- Marshall Farm
W. H. Huel Company


Ft. from N. Line

~~660~~
~~700~~ 800

Ft. from S. Line

760 Ft. from E. Line480
~~660~~

Ft. from W. Line

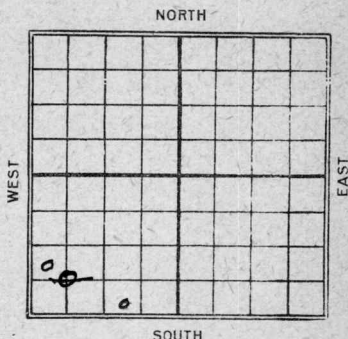

REPORT

Date

6/10 Location

6/18 Roy

8/26 Top Line. 2410

20384. 2450

15 KANSAS
 Map No. _____ Sec. 1 Twp. 24 R. 9
Well No. #5 MarshallArk Fuel Company_____
Contractor

FIRST REPORT

SECTION PLAT

Ft. from N. Line200 Ft. from S. Line760 Ft. from E. Line_____
Ft. from W. Line

o	x		

Location ✓ ✓

Rig up _____

Drilling and Remarks:

RECORD

Cased _____ in., _____ ft.

Sand _____

Gas _____

Oil _____

Total Depth _____

PRODUCTION

1st 24 hrs. Nat. _____

1st 24 hrs. after shot _____

Gas _____ Cu. Ft.

Dry Hole _____

Abandoned _____

Date

JUN 10 1924

M. A. BENEAR

192

Scout

15 KANSAS
Map No. _____ Sec. 1 Twp. 24 R. 9
Well No. 5 - Marshall
Pink Fuel Company

Contractor
Location changed

SECTION PLAT

0	7		

Ft. from N. Line
660
Ft. from S. Line

Ft. from E. Line
660
Ft. from W. Line
FIRST REPORT

Location _____ Rig up _____ Drilling and Remarks: R.O. L	RECORD Cased _____ in., _____ ft. Sand _____ Gas _____ Oil _____ Total Depth _____
	PRODUCTION 1st 24 hrs. Nat. _____ 1st 24 hrs. after shot _____ Gas _____ Cu. Ft. Dry Hole _____ Abandoned _____

15 KANSAS Map No. _____ Sec. 1 Twp. 34 R. 9

Well No. 5 Marshall

Ark Fuel Company

Contractor

ABANDONED SECTION PLAT

_____ Ft. from N. Line

200 _____ Ft. from S. Line

_____ Ft. from E. Line

480 _____ Ft. from W. Line

5	2		

Location _____

Rig up _____

Drilling and Remarks:

Tap L. 2410
2049
2450'

RECORD

Cased _____ in., _____ ft.

Sand _____

Gas _____

Oil _____

Total Depth _____

PRODUCTION

1st 24 hrs. Nat. _____

1st 24 hrs. after shot _____

Gas _____ Cu. Ft.

Dry Hole _____

Abandoned _____

Date

AUG 26 1924

1924

M. A. BENEAR

Scout