

Map No. _____ Sec. 1 Twp. 24 R. 9

Well No. 1 3 Marshall Farm
Arkansas Fuel Oil Company

WEST

EAST

SOUTH

NORTH

Drilling Remarks

Drilling Remarks

Cased _____ in. _____ ft.

Sand

Gas

Oil

Total Depth.....

1st 24 hrs. Nat.

1st. 24 hrs. after shot_____

Gas_____cu. ft.

Dry Hole

Abandoned _____


Map No. Kans Sec. 1 Twp. 24 R. 9
 Well No. 13 Marshall Farm
Arkansas Fuel Oil Company

1120 Ft. from N. Line

_____ Ft. from S. Line

1120 Ft. from E. Line

_____ Ft. from W. Line

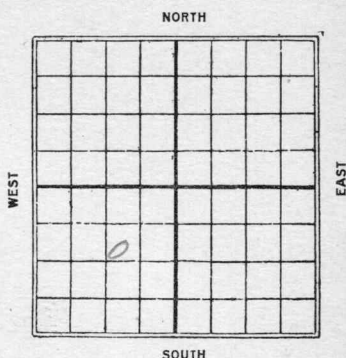

1925

Date REPORT

8/14 B. mg
 8/20 Rign up
 8/27 - 800'
 9/3 S.D. 1200'
 9/11 S.D. 1490'
 9/16 Tap sand 2284-2325 600' w in hole
~~9/24~~ Nat will shoot 100 gts
 9/24
 9/25 Sand 2284-2325
 100 gts 40 Bbls

Map No. 15 **KANSAS** Sec. 1 Twp. 74 R. 9
 Well No. 13 **Marshall**

Contractor

FIRST REPORTS

SECTION PLAT

1120 Ft. from N. Line

Ft. from S. Line

1120 Ft. from E. Line

Ft. from W. Line

Location

Rig up Blog

Drilling and Remarks:

RECORD

Cased _____ in., _____ ft.

Sand _____

Gas _____

Oil _____

Total Depth _____

PRODUCTION

1st 24 hrs. Nat. _____

1st 24 hrs. after shot _____

Gas _____ Cu. Ft.

Dry Hole _____

Abandoned _____

Date

AUG 14 1925

CHAS. L. SHERWOOD

192

Scout

Map No. 15 **KANSAS** Sec. 1 Twp. 24 R. 9

Well No. 13 Marshall
W. K. L. & Co. Company

Contractor

COMPLETED

SECTION PLAT

1120 Ft. from N. Line

_____ Ft. from S. Line

1120 Ft. from E. Line

_____ Ft. from W. Line

Location _____

Rig up _____

Drilling and Remarks:

RECORD

Cased _____ in., _____ ft.

Sand 2284-2325'

Gas _____

Oil _____

Total Depth 2325'

PRODUCTION

1st 24 hrs. Nat. _____

1st 24 hrs. after shot _____

Gas _____ Cu. Ft.

Dry Hole _____

Abandoned _____

Date

SEP 25 1925

192

CHAS. L. SHERWOOD

Scout

100/40 bhs.