

Manassas MAP NO. 71


65^R 17^R Maryland Oil COMPANY

30 A.L. Low FARM WELL NO. 1

COMMENCED 11-11 1926
COMPLETED 9-30 1926

ALTITUDE REMARKS

PRODUCTION

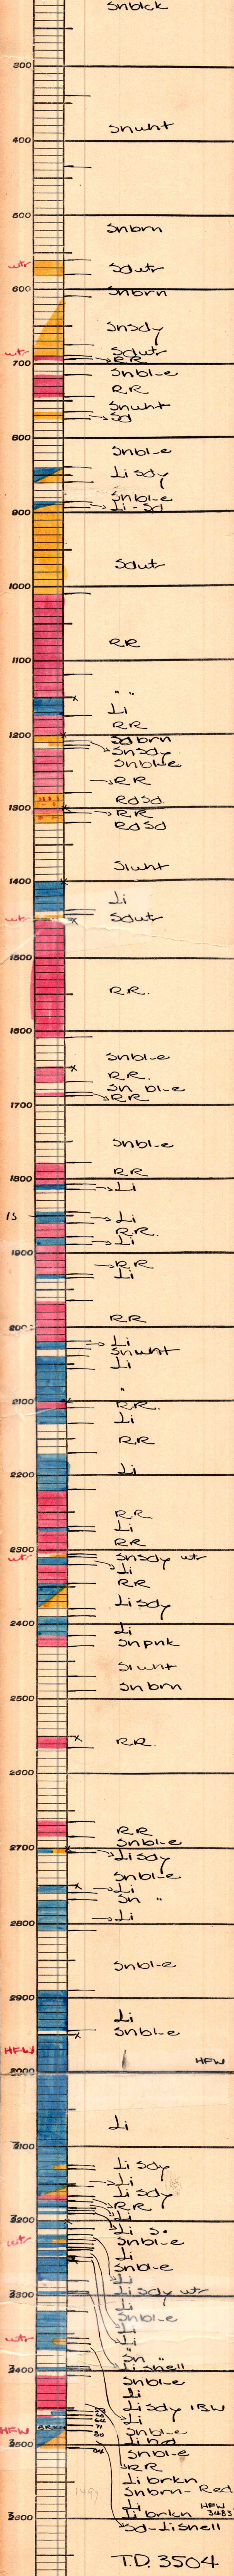

T.D. 3504