


Map No. _____ Sec. 11 Twp. 24 R. 9

Well No. 1 Anderson Farm
Mid Kansas Company

NORTH

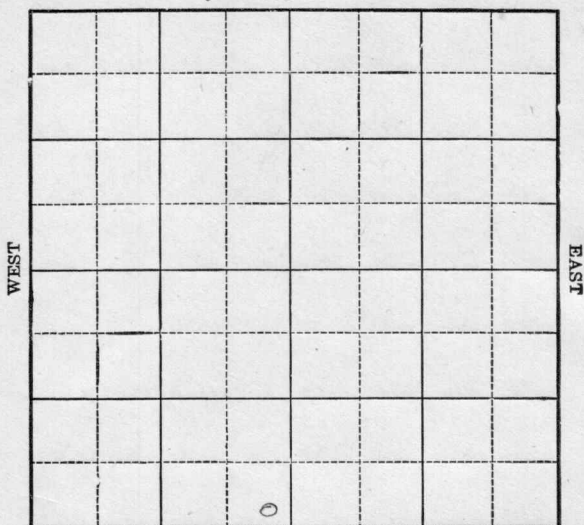

SOUTH

Location _____

Drilling Remarks:

Rig Up _____

Drilling Remarks:

RECORD

Cased _____ in. _____ ft.

Sand _____

Gas _____

Oil _____

Total Depth_____

PRODUCTION

1st 24 hrs. Nat. _____

1st 24 hrs. after shot_____

Gas _____ cu. ft.

Dry Hole _____

Abandoned _____


Map No. K Sec. 11 Twp. 24 R. 9
Well No. 1 Anderson Farm
Mid Kansas Company

_____ Ft. from N. Line

200 Ft. from S. Line

200 Ft. from E. Line

_____ Ft. from W. Line

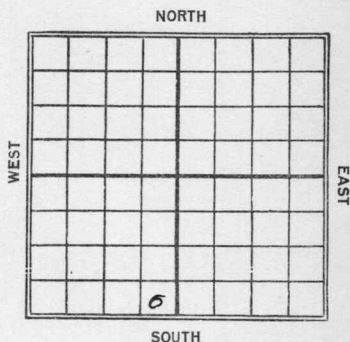

REPORT

Date 1/24

1/15 Ray

2/27 Sand 2136-2188

Sand shale 2188-

320. 2203 -

160/175 Bbls

Map No. **KANSAS** ¹³ Sec. 11 Twp. 24 R. 9

Well No. 1 Anderson

McK. Kansas Company

Contractor

FIRST REPORT

SECTION PLAT

----- Ft. from N. Line

200 Ft. from S. Line

200 Ft. from E. Line

----- Ft. from W. Line

Location -----

Rig up -----

Drilling and Remarks:

R.O. G.

RECORD

Cased ----- in., ----- ft.

Sand -----

Gas -----

Oil -----

Total Depth -----

PRODUCTION

1st 24 hrs. Nat. -----

1st 24 hrs. after shot -----

Gas ----- Cu. Ft.

Dry Hole -----

Abandoned -----

Date

JAN 15 1924

M. A. BENEAR

----- 191 -----

----- Scout

Map No. **KANSAS** *15* Sec. *11* Twp. *24* R. *9*Well No. *#1 - Gundersen**Mid-Kansas* Company

Contractor

SECTION PLAT

COMPLETED

Ft. from N. Line

300' Ft. from S. Line*200'* Ft. from E. Line

Ft. from W. Line

Location

Rig up

Drilling and Remarks:

*Sand 2136-2188**sandy shale 2188**2203 S.O.**160/175 bbl*

RECORD

Cased _____ in., _____ ft.

Sand _____

Gas _____

Oil _____

Total Depth _____

PRODUCTION

1st 24 hrs. Nat. _____

1st 24 hrs. after shot _____

Gas _____ Cu. Ft.

Dry Hole _____

Abandoned _____

Date

FEB 27 1924**M. A. BENEAR**

192

Scout