
FORM 51 25M 8-50 WESTERN Greenwood KANSAS

Section 6 Township 24 Range 9 E

Well No. # 1 Zebold

Company Saturn Drlg.

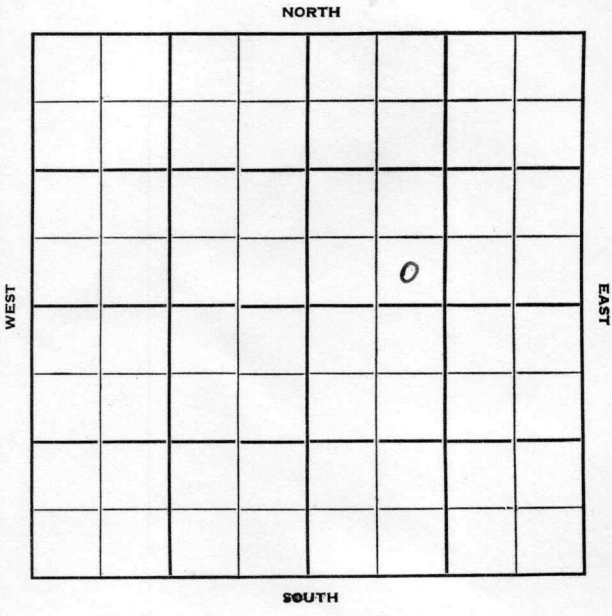

FORM 252-B
10M 8-51 TPCO.

Greenwood KANSAS ✓

Sec. 6 Twp. 24 R. 9 E

Well No. # 1 Zebold Farm

Saturn Drlg. Company

Contractor

Wildcat


Ft. from N. Line

330 Ft. from S. Line

Ft. from E. Line

990 Ft. from W. Line

SE SW NE
Carter Acreage

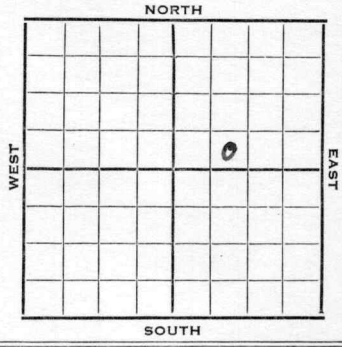

1952	Elev. 1366' REPORT
9/4	Spud 8-25-52 D & A TD 2484' 8" @ 31' Lans. 1405' KC 1680' B KC 1832' Oswego 1967' Miss 2439' TD 2484' D & A FIRST REPORT ABANDONED

FORM 275 FOR SALE BY KANSAS BLUE PRINT CO.

County Greenwood State Kansas

Sec. 8 (Blk. Twp.) 24 (Sur. Rge.) 9E Map No.

Operator Saturn Drlg.

Well No. 1 Farm Zebold

Elev. 1366 Location SE SW NE



330 Ft. From S Line NE

990 Ft. From W Line Quarter

1st. Report SEP 4 1952

Completion SEP 4 1952

Remarks Carter acreage

Spudding Date 8-25-52

Drlg. Data D & A TD 2484 Wildcat

8" @ 31 Lans. 1405 KC 1680 B KC 1832

Oswego 1967 Miss. 2438 TD 2484

D & A

J. G. McGEHEE