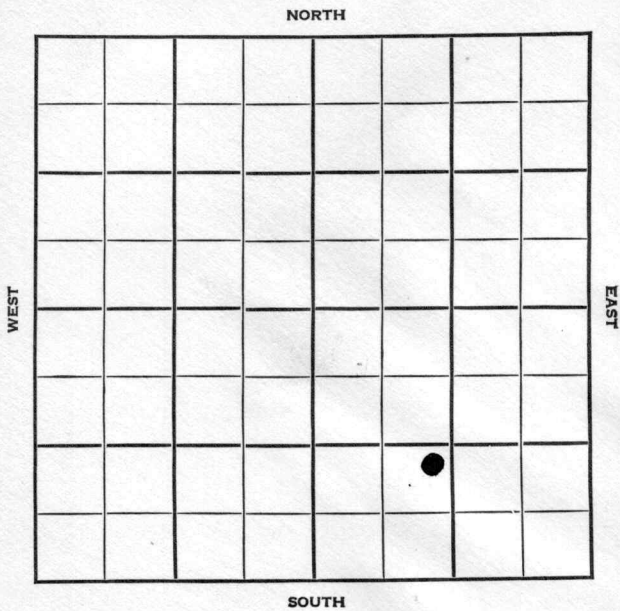


KANSAS

Greenwood ✓

Section 11 Township 24 Range 9EWell No. #1 SWD AndersonCompany Ohio Oil Co.

Greenwood

Sec. 11 Twp. 24 R. 9E

Well No. #1 SWD Anderson Farm

Ohio Company


 Ft. from N. Line

1090 Ft. from S. Line

 Ft. from E. Line

1120 Ft. from W. Line

NE SW SE

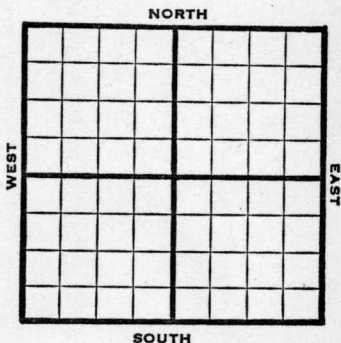

1947

REPORT

10/29 Bart 2154'
Mississippi 2288'
Kind. 2534'
Viola 2588'
Simpson 2620'
Arbuckle 2695'
SWD
TD 2725'

FIRST REPORT
+
ABANDONED

Map No. 15 Sec. 11 Twp. 24 R. 9E

Well No. 1 SWD Anderson

Ohio Company

FIRST REPORT

and Contractor

NE SW SE

ABANDONED

SECTION PLAT

 Ft. from N. Line

1090 Ft. from S. Line

 Ft. from E. Line

1120 Ft. from W. Line

Greenwood County

Location

Rig up

Drilling and Remarks:

Bart. 2154

Miss. 2288

Kind. 2534

Viola 2588

Simp. 2620

Arb. 2695

SWD

RECORD

Cased in., ft.

Sand

Gas

Oil

Total Depth 2725

PRODUCTION

1st 24 hrs. Nat.

1st 24 hrs. after shot

Gas Cu. Ft.

Dry Hole

Abandoned

Date

OCT 29 1947 19

S. J. LEWIS

Scout