

Map No. _____ Sec. 11 Twp. 24 R. 9

Well No. 2 Lewis Farm

Rogers et al

Company

Palhamus (KGS DRL) NORTH

WEST

EAST

SOUTH

Location _____

Drilling Remarks:

Rig Up _____

Drilling Remarks:

RECORD

Cased_____ in._____ ft.

Sand _____

Gas _____

Oil_____

Total Depth_____

PRODUCTION

1st 24 hrs. Nat. _____

1st 24 hrs. after shot_____

Gas _____ cu. ft.

Dry Hole _____


Abandoned _____

Map No. X Sec. 11 Twp. 24 R. 9Well No. 1 Lewis FarmBoggs Etal Company
Packman

Ft. from N. Line

700 Ft. from S. Line660 Ft. from E. Line

Ft. from W. Line

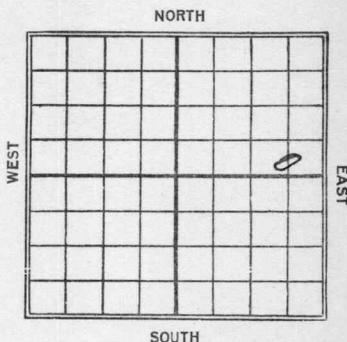

REPORT

1/15 dly 500'3/14 Top sand. 2268'

pay - 22776 2340

J.L. 2342'

135/200 Bbk

Map No. **KANSAS** Sec. **11** Twp. **24** R. **9**Well No. **Lewis****Ragers et al.** Company

Contractor

FIRST REPORT

SECTION PLAT

			o

Ft. from N. Line

200 Ft. from S. Line**660** Ft. from E. Line

Ft. from W. Line

Location

Rig up

Drilling and Remarks:

200' 1/4" at 500'

RECORD

Cased _____ in., _____ ft.

Sand _____

Gas _____

Oil _____

Total Depth _____

PRODUCTION

1st 24 hrs. Nat. _____

1st 24 hrs. after shot _____

Gas _____ Cu. Ft.

Dry Hole _____

Abandoned _____

Date

JAN 15 1924**M. A. BENEAR**

191

Scout

Map No. KANSAS 15 Sec. 11 Twp. 24 R. 9

Well No. 1 Lewis

Palhamus et al Company

was reported as Rogers et al Contractor

SECTION PLAT

COMPLETED

_____ Ft. from N. Line

200 Ft. from S. Line

660' Ft. from E. Line

_____ Ft. from W. Line

Location _____

Rig up _____

Drilling and Remarks:

Tap S. 2268

" pay 2277 to

2340

T.D. 2342

135/200

RECORD

Cased _____ in., _____ ft.

Sand _____

Gas _____

Oil _____

Total Depth _____

PRODUCTION

1st 24 hrs. Nat. _____

1st 24 hrs. after shot _____

Gas _____ Cu. Ft.

Dry Hole _____

Abandoned _____

Date

MAR 14 1924

M. A. BENEAR

_____ 192_____ Scout