


Map No. 11 Sec. 11 Twp. 24 R. 9
Well No. 1 Leaves Farm
Durby et al Company

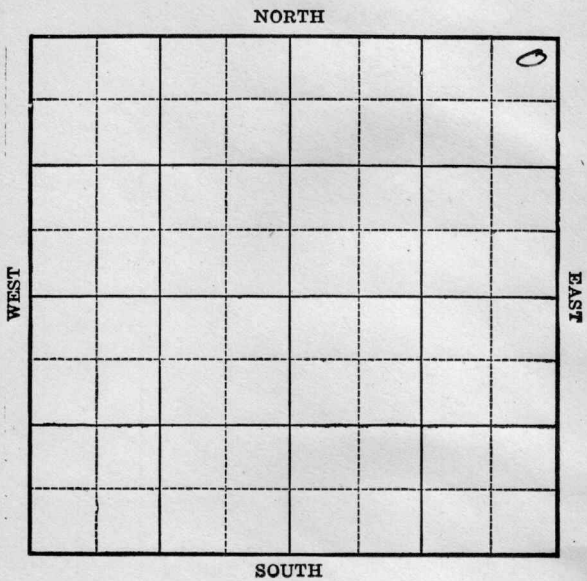

Location _____

Drilling Remarks:

Rig up _____

Drilling Remarks:

RECORD

Cased _____ in. _____ ft.

Sand _____

Gas _____

Oil _____

Total Depth _____

PRODUCTION

1st 24 hrs Nat. _____

1st 24 hrs. after shot _____

Gas _____ cu. ft.

Dry Hole _____


Abandoned _____

Map No. K Sec. 11 Twp. 24 R. 9Well No. 1 Lewis Farm
Duby Et al Company200 Ft. from N. Line

_____ Ft. from S. Line

200 Ft. from E. Line

_____ Ft. from W. Line

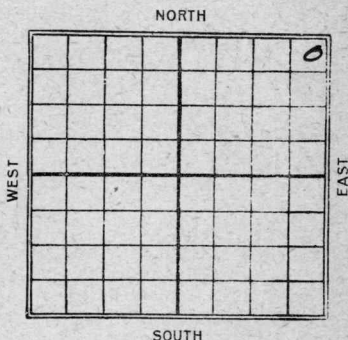

Date

REPORT

19245/22 Reg Bl Lg7/16 - T.D. 2247 F.O. 2246T.D. 2290140/20

15 KANSAS Map No. Sec. 11 Twp. 24 R. 9

Well No. #1 - Lewis
 Derby et al Company
 Contractor

FIRST REPORT

SECTION PLAT

200 Ft. from N. Line

_____ Ft. from S. Line

200 Ft. from E. Line

_____ Ft. from W. Line

			6

Location _____

Rig up _____

Drilling and Remarks:

Rig bldg

RECORD

Cased _____ in., _____ ft.

Sand _____

Gas _____

Oil _____

Total Depth _____

PRODUCTION

1st 24 hrs. Nat. _____

1st 24 hrs. after shot _____

Gas _____ Cu. Ft.

Dry Hole _____

Abandoned _____

Date

MAY 22 1924

192

M. A. BENEAR

Scout

15 *Kans 11* Twp. *24 R. 9*
 Map No. Sec. Twp. R.
 Well No. *1 Lewis Oil*
Leuby Oil Company
 Contractor

COMPLETED

SECTION PLAT

200' Ft. from N. Line

_____ Ft. from S. Line

200' Ft. from E. Line

_____ Ft. from W. Line

			0

Location _____

Rig up _____

Drilling and Remarks:

*Tap 0.2247**2290 - T.D.**140/20 lbs*

RECORD

Cased _____ in., _____ ft.

Sand _____

Gas _____

Oil _____

Total Depth _____

PRODUCTION

1st 24 hrs. Nat. _____

1st 24 hrs. after shot _____

Gas _____ Cu. Ft.

Dry Hole _____

Abandoned _____

Date

M.A.B. 7/23/24
 _____ 192 _____ Scout