


Map No. 75 Sec. 11 Twp. 24 R. 9Well No. 2 Lewis Farm
Shirby Company660 Ft. from N. Line

_____ Ft. from S. Line

200 Ft. from E. Line

_____ Ft. from W. Line

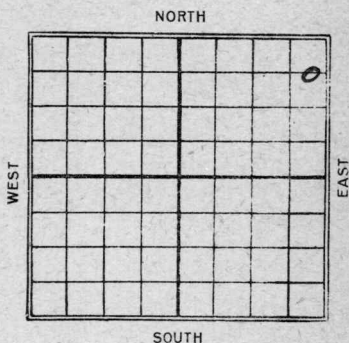

Date 1924 REPORT
5/22 Ray
6/18 2251-93
1207150 BHS

¹⁵ **KANSAS**
 Map No. _____ Sec. 11 Twp. 24 R. 9

Well No. 2 - Lewis

Kearney Company

Contractor

FIRST REPORT

SECTION PLAT

660 Ft. from N. Line

_____ Ft. from S. Line

200 Ft. from E. Line

_____ Ft. from W. Line

			0

Location _____

Rig up _____

Drilling and Remarks:

R.O.G.

RECORD

Cased _____ in., _____ ft.

Sand _____

Gas _____

Oil _____

Total Depth _____

PRODUCTION

1st 24 hrs. Nat. _____

1st 24 hrs. after shot _____

Gas _____ Cu. Ft.

Dry Hole _____

Abandoned _____

Date

M. A. BENEAR

MAY 22 1924

192

Scout

15 KANSAS
 Map No. _____ Sec. 11 Twp. 24 R. 9

Well No. 2 Lewis _____

Deerby Oil _____ Company

_____ Contractor

COMPLETED SECTION PLAT

660 Ft. from N. Line

_____ Ft. from S. Line

200 Ft. from E. Line

_____ Ft. from W. Line

			0

Location _____

Rig up _____

Drilling and Remarks:

RECORD

Cased _____ in., _____ ft.

Sand _____

Gas _____

Oil _____

Total Depth _____

PRODUCTION

1st 24 hrs. Nat. _____

1st 24 hrs. after shot _____

Gas _____ Cu. Ft.

Dry Hole _____

Abandoned _____

Date

JUN 18 1924

M. A. BENEAR

192

Scout