
Form 51—5M—3-26—22544

Map No. KANSAS Sec. 14 Twp. 23 R. 9

Well No. 6 — Green Farm

J. B. Murphy Company

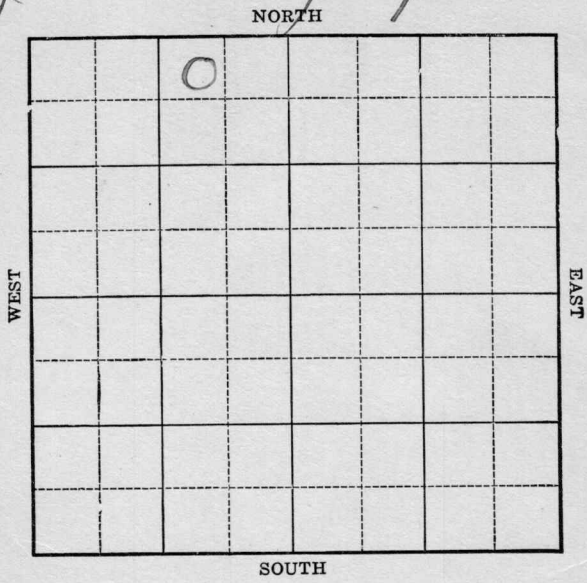

Location

Drilling Remarks

Rig Up

Drilling Remarks

RECORD

Cased ____ in. ____ ft.

Sand

Gas

Oil

Total Depth

PRODUCTION

1st 24 hrs. Nat.

1st 24 hrs. after shot

Gas ____ cu. ft.

Dry Hole


Abandoned

Form 252A—5M—10-26—24951

Map No. KANSAS Sec. 14 Twp. 23 R. 9

Well No. 6 – Green Farm

J B. Murphy Company

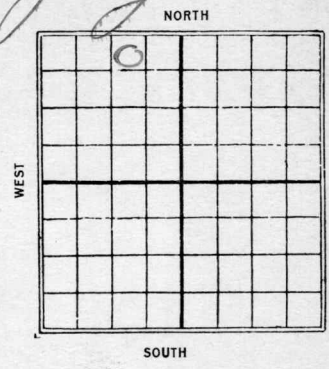

330 Ft. from N. Line

Ft. from S. Line

990 Ft. from E. Line

Ft. from W. Line

1927

Date	REPORT
12/7	R. O. G.
12/14	Timbers
12/21	Rig
12/29	—
1928	
1/5	Rig
1/11	Spudding 175'
1/18	Drlg - 1000
1/26	" 1560
2/2	Top Sand 2279 - Show oil - fishing 2328 -
2/9	—
2/16	Trying to drill by Cog at 2328 -
2/23	—
3/1	—
3/8	2270-2368 small show T.D. 2368 D & A.

Form 26—1M Bks.—3-23—11959. Sherwood

15 KANSAS

Map No._____ Sec. 14 Twp. 23 R. 9

Well No. 6 Green

J. B. Murphy Company

_____ Contractor

FIRST REPORTS


330 Ft. from N. Line

_____ Ft. from S. Line

990 Ft. from E. Line

_____ Ft. from W. Line

SECTION PLAT

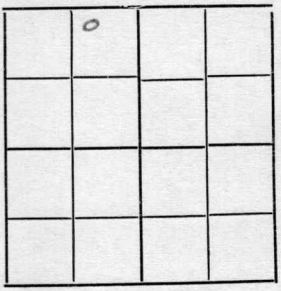

Location _____

Rig up Oct 4

Drilling and Remarks:

RECORD

Cased _____ in., _____ ft.

Sand _____

Gas _____

Oil _____

Total Depth _____

PRODUCTION

1st 24 hrs. Nat. _____

1st 24 hrs. after shot _____

Gas _____ Cu. Ft.

Dry Hole _____

Abandoned _____

Date

DEC 7 1927

_____ 192____

CHAS. L. SHERWOOD

_____ Scout

Form 26—1M Bks.—3-23—11959. Sherwood

15 KANSAS

Map No. ---------- Sec. 14 Twp. 23 R. 9

Well No. 6 Green

J. B. Murphy ---------- Company

---------- Contractor

COMPLETED

330 Ft. from N. Line


--------- Ft. from S. Line

990 Ft. from E. Line

--------- Ft. from W. Line

ABANDONED

SECTION PLAT

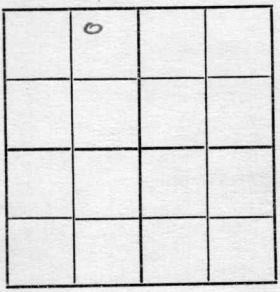

Location ----------

Rig up ----------

Drilling and Remarks:

Dta 2368'

RECORD

Cased ---------- in., ---------- ft.

Sand 2270-2368

Gas Mass Shut

Oil ----------

Total Depth 2368

PRODUCTION

1st 24 hrs. Nat. ----------

1st 24 hrs. after shot ----------

Gas ---------- Cu. Ft.

Dry Hole ✓

Abandoned ----------

Date

MAR 8 1928

---------- 192---. CHAS. L. SHERWOOD ---------- Scout