


Map No. KANSAS Sec. 14 Twp. 23 R. 9
Well No. 7 - Green Farm
Murphy et al Company

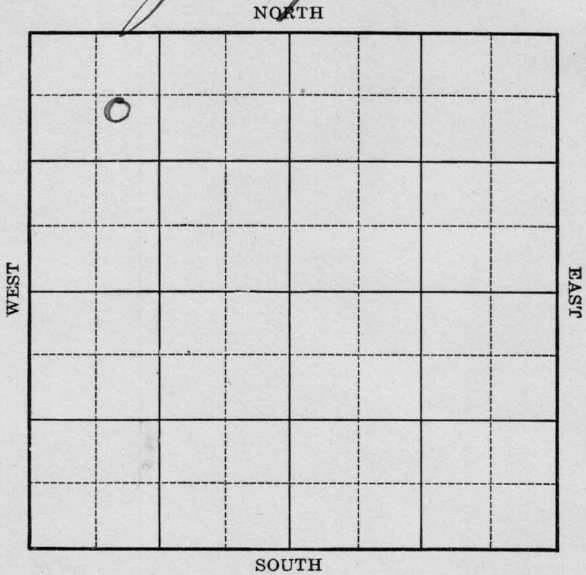

Location _____
Drilling Remarks _____

Rig Up _____
Drilling Remarks _____

RECORD

Cased _____ in. _____ ft.
Sand _____
Gas _____
Oil _____
Total Depth _____

PRODUCTION

1st 24 hrs. Nat. _____
1st 24 hrs. after shot _____
Gas _____ cu. ft.
Dry Hole _____
Abandoned _____

Map No. KANSAS Sec. 14 Twp. 23 R. 9
 Well No. 7- Green Farm
Murphy et al Company


850 Ft. from N. Line

..... Ft. from S. Line

..... Ft. from E. Line

900 Ft. from W. Line

1928

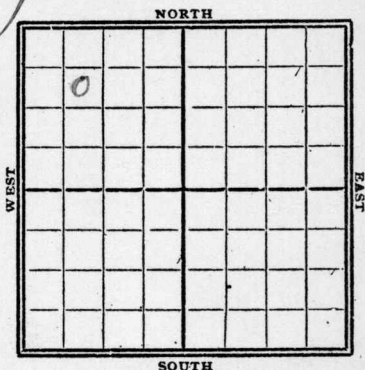

Date

REPORT

7/19 7/26 8/2 8/8	<i>Spudg</i> <i>Drfg 1100.</i> <i>" 1750</i> <i>Sand 2241-2312</i> <i>160 gts 200 bbls</i>
--------------------------------------	---

K15 KANSAS

MAP NO. _____ SEC. 14 TWP. 23 R. 9WELL NO. 7 Sherwood

COMPANY

CONTRACTOR

FIRST REPORTS

850 FT. FROM N. LINE

_____ FT. FROM S. LINE

_____ FT. FROM E. LINE

900 FT. FROM W. LINE

SECTION PLAT

0			

LOCATION _____

RIG UP _____

DRILLING AND REMARKS:

Apdg

RECORD

CASED _____ IN. _____ FT.

SAND _____

GAS _____

OIL _____

TOTAL DEPTH _____

PRODUCTION

1ST 24 HRS. NAT. _____

1ST 24 HRS. AFTER SHOT _____

GAS _____ CU. FT.

DRY HOLE _____

ABANDONED _____

DATE

JUL 19 1928

CHAS. L. SHERWOOD

SCOUT

15 KANSAS
 Map No. _____ Sec. 14 Twp. 23 R. 9
 Well No. 7 Green
Murphy et al Company
 _____ Contractor

COMPLETED

SECTION PLAT

850 Ft. from N. Line
 _____ Ft. from S. Line
 _____ Ft. from E. Line
900 Ft. from W. Line

0			

Location _____

Rig up _____

Drilling and Remarks:

1600 200 lbs.

RECORD

Cased _____ in., _____ ft.

Sand 2241-2312

Gas _____

Oil _____

Total Depth 2312

PRODUCTION

1st 24 hrs. Nat. _____

1st 24 hrs. after shot _____

Gas _____ Cu. Ft.

Dry Hole _____

Abandoned _____

Date

AUG 3 1928

CHAS. L. SHERWOOD

192

Scout