


Map No. 55 Sec. 14 Twp. 23 R. 9
Well No. 4 - Green Farm
J. B. Murphy Company

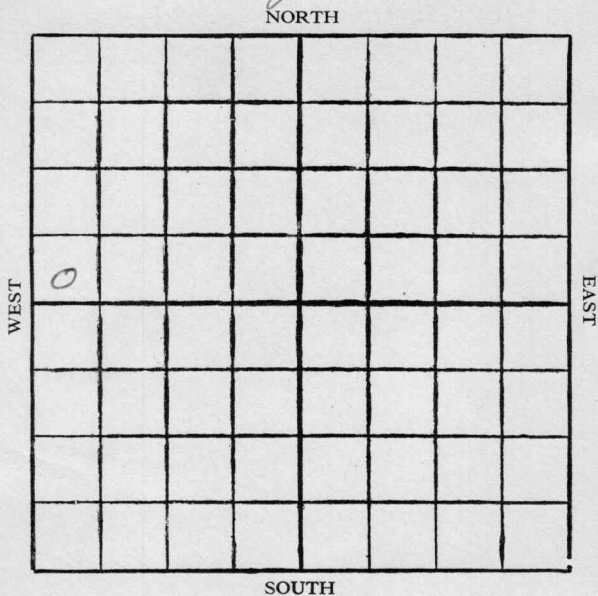

Location

Drilling Remarks

Rig Up

Drilling Remarks

RECORD

Cased in. ft.

Sand

Gas

Oil

Total Depth

PRODUCTION

1st 24 hrs. Nat.

1st 24 hrs. after shot

Gas cu. ft.

Dry Hole

Abandoned

Greenwood

Map No. 15 Sec. 14 Twp. 23 R 9

Well No. 4 - Green Farm

J. B. Murphy Company


NORTH

Ft. from N. Line

330 Ft. from S. Line

Ft. from E. Line

330 Ft. from W. Line

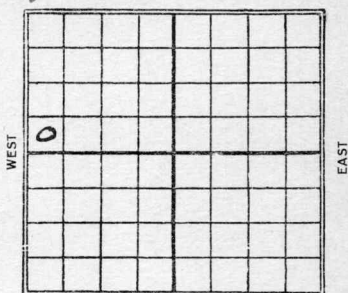

SOUTH

Date

REPORT

12/15 R.O.G.
 12/22 Bldg rig
 12/30 Rig
 1/16 spudding
 1/13 Drlg 490
 1/19 fishing 1250
 1/26 same
 2/3 Drlg 1725
 2/10 sand 2290-2317-dry
 Drilling 2390
 2/16 dry sand 2290-2317
 Dry sand 2290-2317
 D. + A. 2466

Greenwood
 15 KANSAS Sec. *14* Twp. *23* R. *9*

Well No. *4* *Green*
G. B. Murphy Company

Contractor

FIRST REPORTS

SECTION PLAT

<i>0</i>			

Ft. from N. Line

330
 Ft. from S. Line

Ft. from E. Line

330
 Ft. from W. Line

Location

Rig up

Drilling and Remarks:

B04

RECORD

Cased _____ in., _____ ft.

Sand _____

Gas _____

Oil _____

Total Depth _____

PRODUCTION

1st 24 hrs. Nat. _____

1st 24 hrs. after shot _____

Gas _____ Cu. Ft.

Dry Hole _____

Abandoned _____

Date

DEC 15 1926

CHAS. L. SHERWOOD

192

Scout

15 **KANSAS** *Sec. 14* *Twp. 23* *R. 9*
 Map No. _____ Sec. _____ Twp. _____ R. _____

4 *Green*
 Well No. _____
J. B. Murphy _____ Company

 Contractor

COMPLETED

SECTION PLAT

 Ft. from N. Line

330

 Ft. from S. Line

 Ft. from E. Line

330

 Ft. from W. Line

ABANDONED

0			

Location _____

Rig up _____

Drilling and Remarks:

Dry Sand 2290-
2317

DRH 2466

RECORD

Cased _____ in., _____ ft.

Sand _____

Gas _____

Oil _____

Total Depth *2466*

PRODUCTION

1st 24 hrs. Nat. _____

1st 24 hrs. after shot _____

Gas _____ Cu. Ft.

Dry Hole ☒ _____

Abandoned ☒ _____

Date

FEB 16 1927

CHAS. L. SHERWOOD

192

Scout