


Map No. _____ Sec. 14 Twp. 23 R. 9
 Well No. 5 - Green Farm _____
Murphy et al Company _____

NORTH

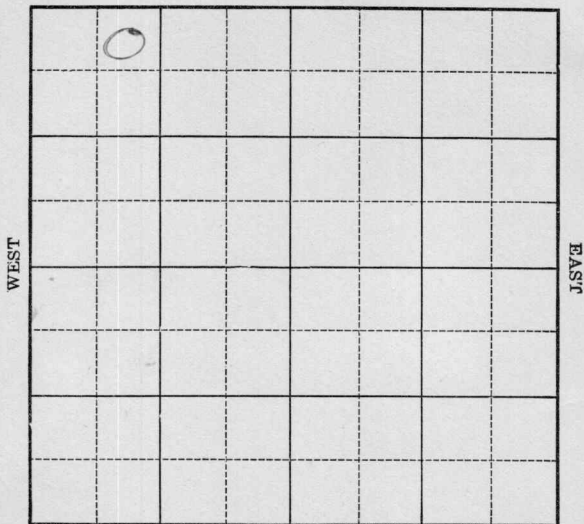

SOUTH

Location _____

Drilling Remarks _____

Rig Up _____

Drilling Remarks _____

RECORD

Cased _____ in. _____ ft.

Sand _____

Gas _____

Oil _____

Total Depth _____

PRODUCTION

1st 24 hrs. Nat. _____

1st 24 hrs. after shot _____

Gas _____ cu. ft.

Dry Hole _____

Abandoned _____

Map No. _____ Sec. 14 Twp. 23 R. 9


Well No. 5-Green Farm _____
Murphy et al Company _____

330 Ft. from N. Line

_____ Ft. from S. Line

_____ Ft. from E. Line

990 Ft. from W. Line

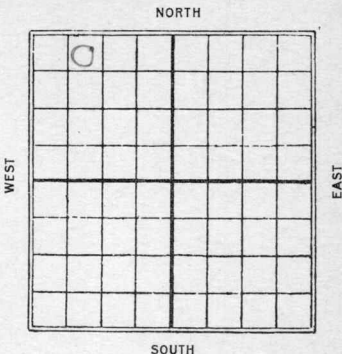

1927

Date

REPORT

11/2 Rig up
11/9 Spudding
11/16 Drill 500

12/7 2292-2332

T.D. 2332

130/200 bbb

Sherwood E

15 KANSAS

Map No. _____ Sec. 14 Twp. 23 R. 9

Well No. 5 Green

Murphy et al Company

Contractor

FIRST REPORTS

230 Ft. from N. Line

Ft. from S. Line

Ft. from E. Line

990 Ft. from W. Line

SECTION PLAT

0			

Location _____

Rig up ✓

Drilling and Remarks:

RECORD

Cased _____ in., _____ ft.

Sand _____

Gas _____

Oil _____

Total Depth _____

PRODUCTION

1st 24 hrs. Nat. _____

1st 24 hrs. after shot _____

Gas _____ Cu. Ft.

Dry Hole _____

Abandoned _____

Date

NOV 2 - 1927

192

CHAS. L. SHERWOOD

Scout

15 KANSAS
 Map No. _____ Sec. 14 Twp. 23 R. 9
 Well No. 5 Green

Murphy et al Company

Contractor

COMPLETED

330 Ft. from N. Line

_____ Ft. from S. Line

_____ Ft. from E. Line

990 Ft. from W. Line

SECTION PLAT

6			

Location _____

Rig up _____

Drilling and Remarks:

Boo 200 ft.

RECORD

Cased _____ in., _____ ft.

Sand 2292-2332

Gas _____

Oil _____

Total Depth 2332

PRODUCTION

1st 24 hrs. Nat. _____

1st 24 hrs. after shot _____

Gas _____ Cu. Ft.

Dry Hole _____

Abandoned _____

Date

DEC 7 1927

CHAS. L. SHERWOOD

192

Scout