




KANSAS

Section 11 Township 23 Range 9E

Well No. #9 West-Green

Company Miller-Snyder

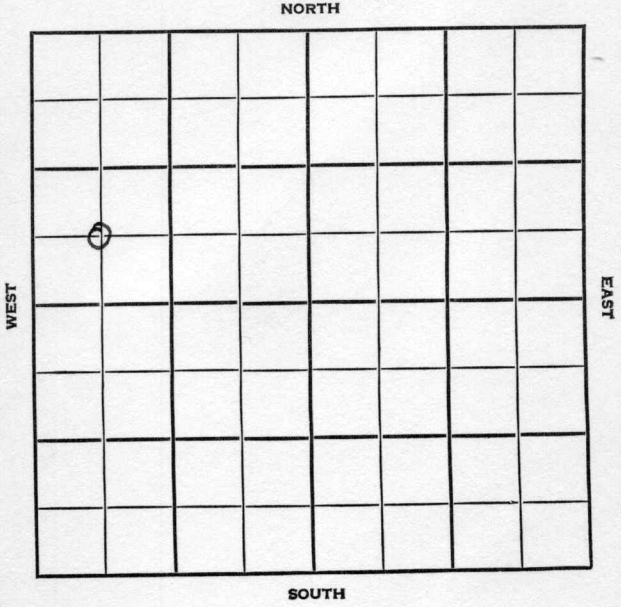

SEC.	TWP.	R.
11	23	9E

WELL NO.

#9 West-Green

FARM

COMPANY

Miller-Snyder

CONTRACTOR

Berentz


Teeter Pool

_____ Ft. from N. Line

660 _____ Ft. from S. Line

_____ Ft. from E. Line

660 _____ Ft. from W. Line

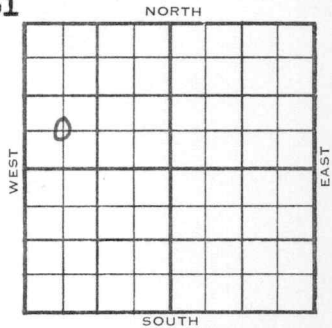

C SW NW

ELEVATION

REPORT

1955

-

4/13

Spud 3-14-55

Oil Well

TD 2359'

8" @ 44'

Bart. 2297'

TD 2349'

5" @ 2303'

CO to 2359 nitro shot P/ 57 bopd.
75% w.

Comp 24 bopd. 75% Wtr.

FIRST REPORT

COMPLETED

County **Greenwood** State **Kansas**
 Sec. **11** (Blk. **23** (Sur. **9E** Map No.
 Operator **Miller-Snyder**
 Well No. **9** Farm **West-Green**
 Elev. Location **C SW NW**

FIRST REPORT									
									
COMPLETE									

660 Ft. From **S** Line **NW**
660 Ft. From **W** Line Quarter
 1st. Report **APR 13 1955**
 Completion **APR 13 1955**
 Remarks **Teeter Pool**
Berentz- Contr.
 Spudding Date **3-14-55**

Drlg. Data **Oil well TD 2359**
8" @ 44 Bart. 2297 TD 2349 5" @ 2303
CO to 2359 nitro shot P/ 57 bopd 75% w
Comp. 24 bopd 75% wtr.

FABEN GILSTRAP