
Form 51—5M—7-25—19786

Map No. Kansas / Greenwood Sec. 11 Twp. 23 R. 9

Well No. 3 Smith Farm

Ward-McGinnis Company

NORTH

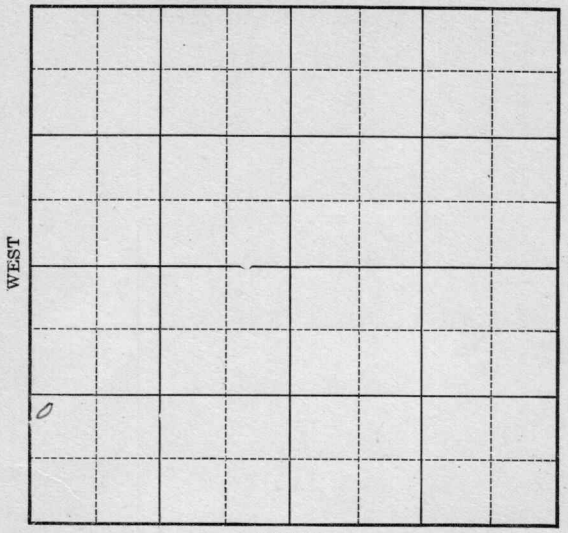

Location

Drilling Remarks

Rig Up

Drilling Remarks

RECORD

Cased in. ft.

Sand

Gas

Oil

Total Depth

PRODUCTION

1st 24 hrs. Nat.

1st 24 hrs. after shot

Gas cu. ft.

Dry Hole


Abandoned

Form 252A—5M—11-25—20913

Map No. Kans. Sec. 11 Twp. 23 R. 9

Well No. # 3 Smith Farm

Ward McGinnis Company

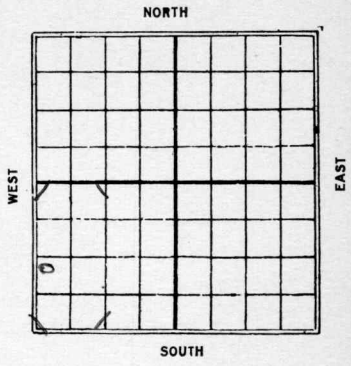

_____ Ft. from N. Line

990 Ft. from S. Line

_____ Ft. from E. Line

330 Ft. from W. Line

1926.

Date	REPORT
5/19	Location
6/2	Rigging up.
6/10	Drlg 2450'
6/18	fishing 1350'
6/25	Drlg 1840
6-30	Sand 2320-40' drlg
7/9	Sand 2320-2345
	T.D. 2346 120 gts
	300 bbls

Form 26—1M Bks.—3-23—11959. Sherwood

Map No. K15 KANSAS Sec. 11 Twp. 22 R. 9


Well No. 3 Smith

Ward Mc Ginnis Company

Contractor

COMPLETED

SECTION PLAT

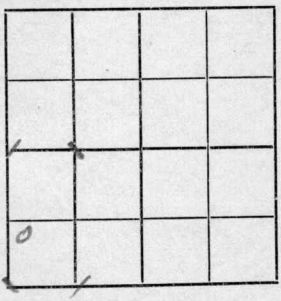

Ft. from N. Line

990 Ft. from S. Line

Ft. from E. Line

330 Ft. from W. Line

Location

Rig up

Drilling and Remarks:

120/300 lbs.

RECORD

Cased in., ft.

Sand 2320-2345

Gas

Oil

Total Depth 2346'

PRODUCTION

1st 24 hrs. Nat.

1st 24 hrs. after shot

Gas Cu. Ft.

Dry Hole

Abandoned

Date

JUL 9 1926

192

CHAS. L. SHERWOOD

Scout

Form 26—1M Bks.—3-23—11959. S Sherwood

K15 KANSAS

Map No. _____ Sec. 11 Twp. 23 R. 9


Well No. 3 Smith

Ward McGinnis Company

_____ Contractor

FIRST REPORTS

SECTION PLAT

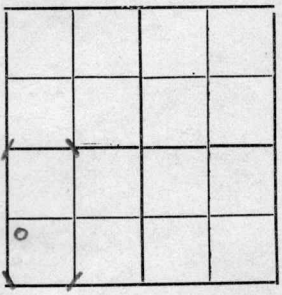

_____ Ft. from N. Line

990 Ft. from S. Line

_____ Ft. from E. Line

330 Ft. from W. Line

Location ✓

Rig up _____

Drilling and Remarks:

RECORD

Cased _____ in., _____ ft.

Sand _____

Gas _____

Oil _____

Total Depth _____

PRODUCTION

1st 24 hrs. Nat. _____

1st 24 hrs. after shot _____

Gas _____ Cu. Ft.

Dry Hole _____

Abandoned _____

Date

MAY 19 1926

192 CHAS. L. SHERWOOD Scout