
Coffey Co.

Form 51—5M—3-26—22544

Map No. SANS Sec. 8 Twp. 22 R. 14

Well No. 1 Miller Farm

Derby Oil Co. Company

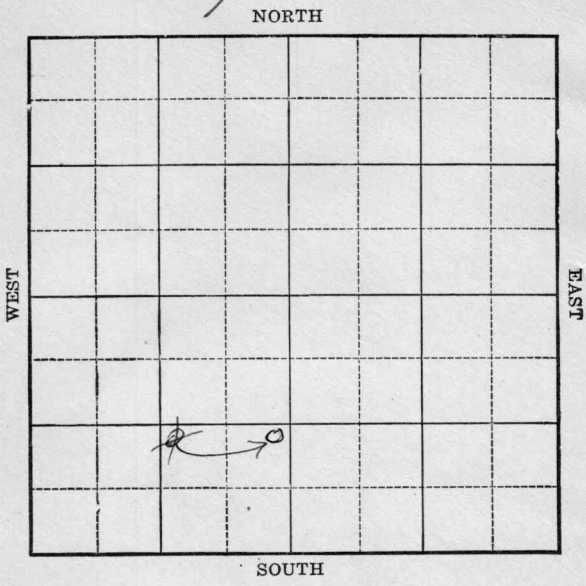

Location

Drilling Remarks

Rig Up

Drilling Remarks

RECORD

Cased ____ in. ____ ft.

Sand

Gas

Oil

Total Depth

PRODUCTION

1st 24 hrs. Nat.

1st 24 hrs. after shot

Gas ____ cu. ft.

Dry Hole

Abandoned


Form 252A—5M—11-25—20913

Coffey Co

Map No. Kansas Sec. 8 Twp. 22 R 14

Well No. 1 Muller Farm

Derby Oil Company

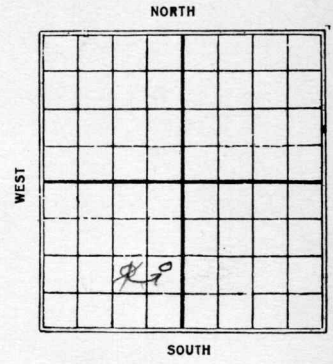

Ft. from N. Line

1120 Ft. from S. Line

~~1120~~ 200 Ft. from E. Line

Ft. from W. Line

Date 1926	REPORT
6/17	Location
6/25	—
6-30	—
7/8	—
7/15	—
7/22	Spudding
7/28	—
8/4	—
8/11	—
8/18	rung 12" 611'
8/25	—
8-31	Clearing out 748
9/15	Drlg 1200'
9/22	—
9/29	I. L. 1707 - D. & A. 1736

Form 26—1M Bks.—3-23—11959.

Coffey Co

no map

Map No. KANSAS Sec. 8 Twp. 22 R. 14


Well No. 1 Miller

Derby Oil Co Company

Contractor

FIRST REPORTS

SECTION PLAT

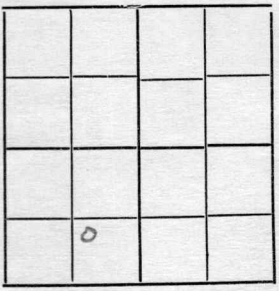

Ft. from N. Line

1120 Ft. from S. Line

1120 Ft. from E. Line

Ft. from W. Line

Location ✓

Rig up

Drilling and Remarks:

RECORD

Cased in., ft.

Sand

Gas

Oil

Total Depth

PRODUCTION

1st 24 hrs. Nat.

1st 24 hrs. after shot

Gas Cu. Ft.

Dry Hole

Abandoned

Date

JUN 17 1926

192 CHAS. L. SHERWOOD Scout

Form 26—1M Bks.—3-23—11959.

C. Offey

no map KANSAS

Map No._____ Sec. 8 Twp. 22 R. 14

Well No. 1 Miller

Dabey Oil Co Company

_____ Contractor

CORRECTION


_____Ft. from N. Line

1120 Ft. from S. Line

300 Ft. from E. Line

_____Ft. from W. Line

SECTION PLAT

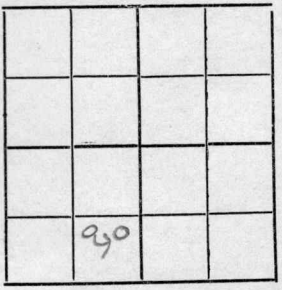

Location _____

Rig up _____

Drilling and Remarks:

Spudding

Cly Rock to

above,

RECORD

Cased_____in., _____ ft.

Sand _____

Gas _____

Oil _____

Total Depth _____

PRODUCTION

1st 24 hrs. Nat. _____

1st 24 hrs. after shot _____

Gas _____Cu. Ft.

Dry Hole _____

Abandoned _____

Date

JUL 2 1 1926

_____192____

CHAS. L. SHERWOOD

_____Scout

Form 26—1M Bks/—3-23—11959.

Coffey Co

no KANSAS

Map No. 1 Sec. 8 Twp. 22 R. 14

Well No. 1 Miller

Derby Oil Co Company

Contractor

COMPLETED

1120 Ft. from N. Line


200 Ft. from S. Line

Ft. from E. Line

Ft. from W. Line

ABANDONED

SECTION PLAT

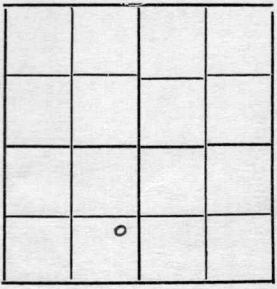

Location

Rig up

Drilling and Remarks:

TL 1707

Dry 1736'

RECORD

Cased in., ft.

Sand

Gas

Oil

Total Depth 1736

PRODUCTION

1st 24 hrs. Nat.

1st 24 hrs. after shot

Gas Cu. Ft.

Dry Hole ✓

Abandoned

Date

SEP 29 1926

192

CHAS I. SHERWOOD

Scout