


Map No. 15 Sec. 4 Twp. 23 R. 2
Well No. 3 Hawk Farm
Mason & Ralston Company

NORTH

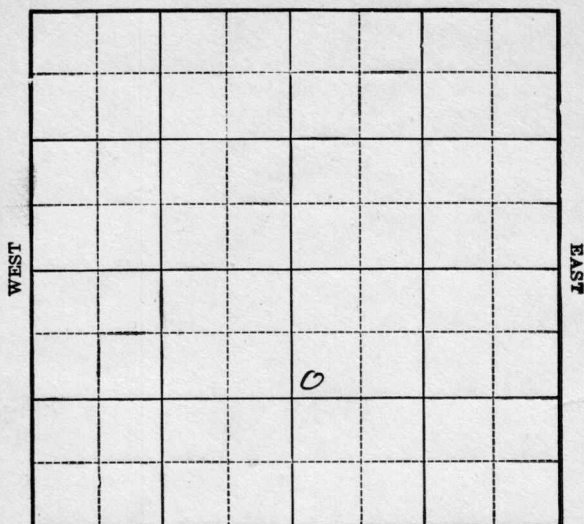

SOUTH

Location _____

Drilling Remarks:

Rig Up _____

Drilling Remarks:

RECORD

Cased _____ in. _____ ft.

Sand _____

Gas _____

Oil _____

Total Depth_____

PRODUCTION

1st 24 hrs. Nat. _____

1st 24 hrs. after shot_____

Gas _____ cu. ft.


Dry Hole _____

Abandoned _____

Map No. 11 Sec. 4 Twp. 23 R. 2Well No. 3 Haw R Farm
Mason Ed. Halston Company1120 Ft. from N. Line

_____ Ft. from S. Line

_____ Ft. from E. Line

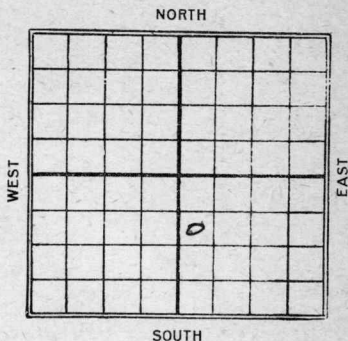200 Ft. from W. LineBenean

REPORT

Date	
<u>9/9</u>	<u>Location</u>
<u>11/26</u>	<u>Rig</u>
<u>12/17</u>	_____
<u>1925</u>	_____
<u>6/2</u>	_____
<u>7-22</u>	_____
<u>7/29</u>	<u>S.D. 1140</u>
<u>8/7</u>	<u>2100</u>
<u>8/14</u>	<u>S.D. 1140</u>
<u>8/19</u>	_____
<u>8/27</u>	_____
<u>9/3</u>	_____
<u>9/9</u>	_____
<u>1926</u>	_____
<u>5/5</u>	<u>Same.</u>
<u>5/12</u>	<u>Same.</u>
<u>5/26</u>	_____
<u>6/2</u>	_____
<u>6/9</u>	_____
<u>6/16</u>	_____
<u>6/23</u>	_____
<u>6/30</u>	_____

7/21 - same

8/4 - T.D. 1140 - D. & A.

13 KANSAS Map No. Sec. 4 Twp. 23 R. 2

Well No. 3 Hawks
Mason & Ralston Company

Contractor

FIRST REPORT

SECTION PLAT

1120' Ft. from N. Line

_____ Ft. from S. Line

_____ Ft. from E. Line

200' Ft. from W. Line

		0	

Location ✓✓

Rig up

Drilling and Remarks:

RECORD

Cased _____ in., _____ ft.

Sand _____

Gas _____

Oil _____

Total Depth _____

PRODUCTION

1st 24 hrs. Nat. _____

1st 24 hrs. after shot _____

Gas _____ Cu. Ft.

Dry Hole _____

Abandoned _____

Date

SEP 9 1924


M. A. BENEAR

Scout

MAP No. K13 SEC. 4 TWP. 23S R. 24EWELL No. 3 ConwayMason + Reelston COMPANY

CONTRACTOR

SECTION PLAT

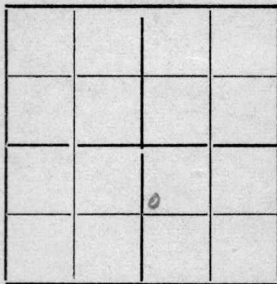

_____ Ft. FROM N. LINE

_____ Ft. FROM S. LINE

_____ Ft. FROM E. LINE

_____ Ft. FROM W. LINE

LOCATION ✓

RIG UP _____

DRILLING AND REMARKS:

*We showed
abd 440
no abd loc
on this hole*

RECORD

CASED _____ IN. _____ FT.

SAND _____

GAS _____

OIL _____

TOTAL DEPTH _____

PRODUCTION

1ST 24 HRS. NAT. _____

1ST 24 HRS. AFTER SHOT _____

GAS _____ CU. FT.

DRY HOLE _____

ABANDONED _____

DATE

7/4 1925 SCOUT

13 *Harvey*
 Map No. **KANSAS** Sec. *4* Twp. *23* R. *2E*

Well No. *3 Hawk**Mason & Ralston* Company

Contractor

SECTION PLAT

Ft. from N. Line

1120 Ft. from S. Line

Ft. from E. Line

200 Ft. from W. Line**ABANDONED**

Location

Rig up

Drilling and Remarks:

*TD 1140**J & A.*

RECORD

Cased _____ in., _____ ft.

Sand _____

Gas _____

Oil _____

Total Depth _____

PRODUCTION

1st 24 hrs. Nat. _____

1st 24 hrs. after shot _____

Gas _____ Cu. Ft.

Dry Hole _____

Abandoned _____

Date

AUG 4 1926

192

S. J. LEWIS

Scout