
Form 51—5M—10-26—Mid-West

Map No. KANSAS Sec. 8 Twp. 22 R. 14

Well No. 1—Mitchell Farm

F. H. Kinney Company

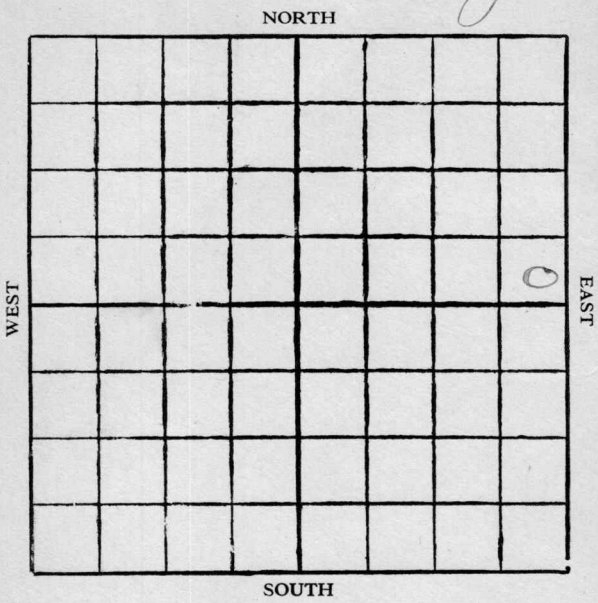


Location	Rig Up
Drilling Remarks	Drilling Remarks
RECORD	PRODUCTION
Cased ..... in. ..... ft.	1st 24 hrs. Nat.
Sand	1st 24 hrs. after shot
Gas	Gas ..... cu. ft.
Oil	Dry Hole
Total Depth	Abandoned

Form 252A—5M—4-27—27425

Map No. KANSAS Sec. 8 Twp. 22 R. 14

Well No. 1—Mitchell Farm

J. H. Finney Company

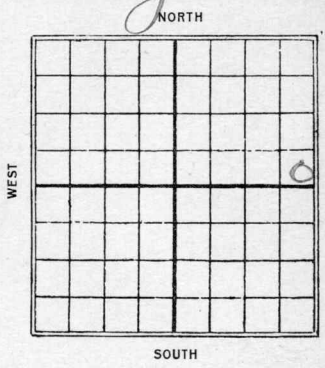

_____ Ft. from N. Line

250 Ft. from S. Line

250 Ft. from E. Line

_____ Ft. from W. Line

1928

Date	REPORT
3/8	Machine
3/16	Spudding
3/22	Spudding 300
3/29	
4/5	Drlg 850
4/12	" 900
4/19	Sand 1358-75 — 1½ M gas drilling —
4/26	(Correction) Sand — 1345-65 2 M gas — fishing tools 1600 —
5/3	Top Lime 1700 — H.F.W. 1705 S.D. May P.B. to gas sand —
5/10	1345-65 T.D. 1705 Top lime 1700' — HFW P.B. 1345-65 2¼ M gas

Form 26—1M Bks.—3-23—11959.

Copper

KANSAS

Map No._____ Sec. 8 Twp. 22 R. 14


Well No. 1 Mitchell

F. A. Finney Company

_____ Contractor

FIRST REPORTS

SECTION PLAT

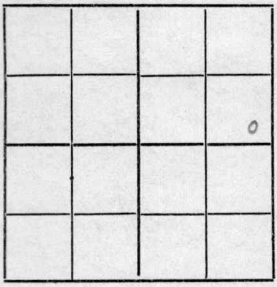

_____Ft. from N. Line

350 Ft. from S. Line

350 Ft. from E. Line

_____Ft. from W. Line

Location Hackney

Rig up Machine

Drilling and Remarks:

RECORD

Cased _____ in., _____ ft.

Sand _____

Gas _____

Oil _____

Total Depth _____

PRODUCTION

1st 24 hrs. Nat. _____

1st 24 hrs. after shot _____

Gas _____ Cu. Ft.

Dry Hole _____

Abandoned _____

Date

MAR. 8 1928 CHAS. L. SHERWOOD

_____192____. _____Scout

FORM 26 250 BKS. 4-28 WESTERN

No Tracing

KANSAS

Coppey

MAP NO. _____ SEC. 8 TWP. 22 R. 14 E


WELL NO. 1 Mitchell

J. A. Finney COMPANY

_____ CONTRACTOR

COMPLETED

SECTION PLAT

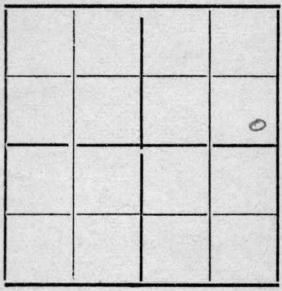

_____ FT. FROM N. LINE

750 FT. FROM S. LINE

750 FT. FROM E. LINE

_____ FT. FROM W. LINE

LOCATION _____

RIG UP _____

DRILLING AND REMARKS:

TL 1700' AFW

1705' TD. PBTD

Sos ~~Sand~~ 1345-65

2¼ ~~AA~~ Sos

RECORD

CASED _____ IN., _____ FT.

SAND _____

GAS 1345-65

OIL _____

TOTAL DEPTH 1705'

PRODUCTION

1ST 24 HRS. NAT. _____

1ST 24 HRS. AFTER SHOT _____

GAS 2¼ M CU. FT.

DRY HOLE _____

ABANDONED _____

DATE

MAY 10 1928

192____

CHAS. L. SHERWOOD

_____ SCOUT