
Form 51 C.O.G.—11-16—2M

Map No_____ Sec 10 Twp 22 R 15

Well No 1 Suntman Farm

Mutual Oil Company

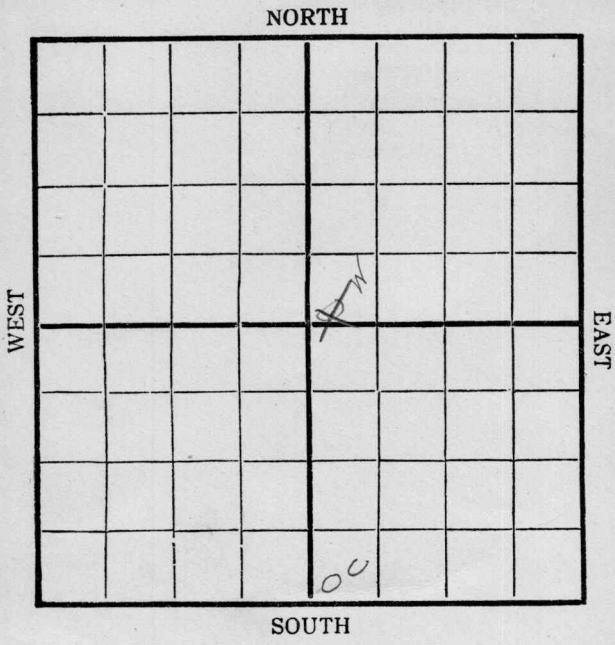

Location _____

Drilling Remarks:

300 - 4/4/17

Rig Up 1917

Drilling Remarks:

RECORD

Cased_____ in_____Ft.

Sand _____

Gas _____

Oil _____

Total Depth_____

PRODUCTION

1st 24 hrs. Nat_____

1st 24 hrs. after shot_____

Gas_____Cu. Ft.

Dry Hole_____

Abandoned _____

FORM 26—6-20-16—500 BOOKS OF 100 DUP.

Map No. none Sec. 10 Twp. 22 R. 15

Well No. 1 Sweetman Farm

Mutual Oil Company

NORTH Texas



Location

Rig Up

Drilling and remarks

RECORD

Cased in. Ft.

Sand

Gas

Oil

Total Depth

PRODUCTION

1st 24 hrs. Nat.

1st 24 hrs. after shot

Gas Cu. Ft.

Dry Hole

Abandoned

Date 12/28, 1916. Melford Scout


28-16—100 BOOKS OF 100 DUP.

Sec. 17 Twp. 22 R. 16

Well No. 1 Rohde Farm

Mutual Oil Company

NORTH

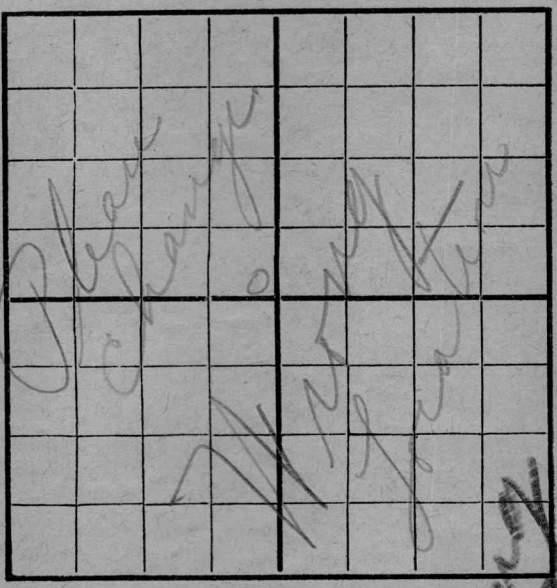

WEST

EAST

SOUTH

Location

Rig Up

Drilling and remarks

Correct.
10-22-15
1 Swetman Farm
Mutual Oil
SW cor NE¼

RECORD

Cased in. Ft.

Sand

Gas

Oil

Total Depth

PRODUCTION

1st 24 hrs. Nat.

1st 24 hrs. after shot

Gas Cu. Ft.

Dry Hole

Abandoned

Date 12/28, 1916, Milford Scout

FORM 26—6-20-16—500 BOOKS OF 100 DUP.

Map No. ____ Sec. 10 Twp. 22 R. 15

Well No. 1 Swentzman Farm

Mutual Oil Company

NORTH

WEST

EAST

SOUTH

Location ____

Rig Up ____

Drilling and remarks

3005 ft.

RECORD

Cased ____ in. ____ Ft.

Sand ____

Gas ____

Oil ____

Total Depth ____

PRODUCTION

1st 24 hrs. Nat. ____

1st 24 hrs. after shot ____

Gas ____ Cu. Ft.

Dry Hole ____

Abandoned ____

Date

7/4, 1917

Mulford Scout