Butler


KANSAS

SECTION 7 TOWNSHIP 24S RANGE 4E

WELL NO. #1 H. Cranston

COMPANY Raymond Oil Co.

NORTH SW SW SE

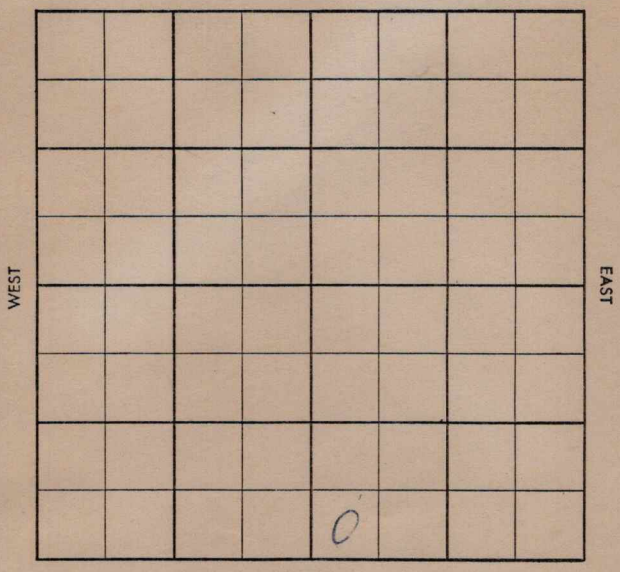

FORM 504-3 SUNRAY

S-513-B

County Butler Elev. 1327 DF

Sec. 7 Twp. 24 Rge. 4E

Company Raymond Oil Co.

Farm Name H. Cranston No. 1

TOPS	DEPTH	LOG	DATUM
Anh.			
Tp.			
H.			
Tr.			
Dg.			
B. L.			
L.			
K.C.			
B.K.C.			
Ce.			
C.			
M.			
M.			
K.			
Mz.			
Mq.			
V.			
S.			
S.			
A.			
R.			
Pf.			
G.			
T.D.			

Loc. in Sec. SW SW SE

Geol.

Contr.

Pool Mellor SE

APR 23 '58

FIRST REPORT

Date Comm.

C & P

Co. Lse. No. Sec. T. R.

Twp. X Pool X

Co. X Facet X

S-513-B

County Butler Elev. 1327 DF 1330 RA

Sec. 7 Twp. 24 Rge. 4E

Company Raymond Oil Co.

Farm Name H. Cranston No. 1

TOPS	DEPTH	LOG	DATUM
Anh.			
Tp.			
H.			
Tr.			
Dg.			
B. L.			
L.	1812		
K.C.	2090		
B.K.C.	2243		
Ce.			
C.			
M. Chat	2275		
M. Pay	2278		
K.			
Mz.			
Mq.			
V.			
S.			
S.			
A.			
R.			
Pf.			
G.			
T.D.	2480		

Loc. in Sec. SW SW SE

Geol.

Contr.

Pool Mellor E

COMPLETE JUN 11 '58

Date Comm. 4-26-58

C & P APR 30 '58 8"c 201 ϕ 1965

MAY 7 '58 5" 2477/50 CO MAY 14 '58

PD 2485 TD FU 600' Fld

80% oil 6 hrs ϕ 9 Bo ph 5 hrs

sgw T&R WO pu MAY 21 '58 MAY 28 '58

JUN 3 '58 JUN 11 '58 Phy P 108 Bo ϕ 1% w

¢