
Coffey

Form 51—5M—2-29—34703

Map No. KANSAS Sec. 20 Twp. 22 R. 15 E

Well No. 1 Wood Farm

McGregor Stal Company

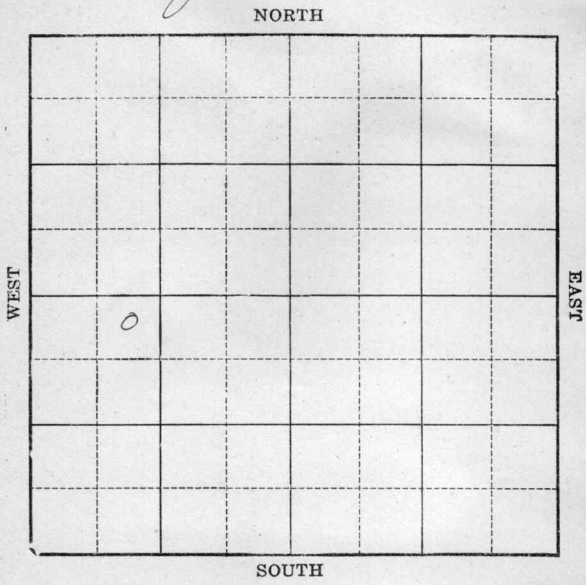

Location

Drilling Remarks

Rig Up

Drilling Remarks

RECORD

Cased in. ft.

Sand

Gas

Oil

Total Depth

PRODUCTION

1st 24 hrs. Nat.

1st 24 hrs. after shot

Gas cu. ft.

Dry Hole

Abandoned

Coffey

Form 252A—5M—11-29—38055

Map No. KANSAS Sec. 20 Twp. 22 R. 15E

Well No. 1 Wood Farm


McGregor Mal Company

250 Ft. from N. Line

Ft. from S. Line

Ft. from E. Line

1120 Ft. from W. Line

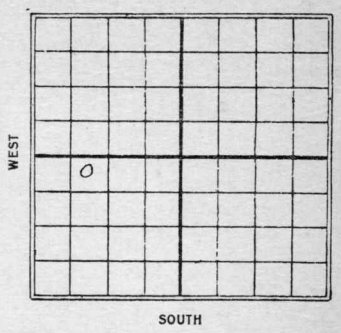

1930

Date	REPORT
7/30	SD 500'
8/6	dry 600'
8/13	SD 600'
8/20	—
8/27	—
9/3	—
9/9	—
9/17	TD. 600
	Dry & Abandon

Form 26—1M Bks.—2-29

KANSAS

Cozzey

Map No. _____ Sec. 20 Twp. 22 R. 15 E

Well No. 1 Wood

McGregor et al Company

Contractor

FIRST REPORTS


1250 Ft. from N. Line

_____ Ft. from S. Line

_____ Ft. from E. Line

1120 Ft. from W. Line

SECTION PLAT

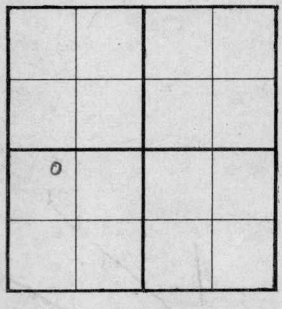

Location _____

Rig up _____

Drilling and Remarks:

8/15 500'

RECORD

Cased _____ in., _____ ft.

Sand _____

Gas _____

Oil _____

Total Depth _____

PRODUCTION

1st 24 hrs. Nat. _____

1st 24 hrs. after shot _____

Gas _____ Cu. Ft.

Dry Hole _____

Abandoned _____

Date

JUL 30 1930

CHAS. L. SHERWOOD

19 _____ Scout

Form 26—1M Bks.—2-29

20 KANSAS Coppey

Map No. Sec. 20 Twp. 22 R. 15

Well No. 1 Wood

Mc Gregor Oil Co Company

Contractor

COMPLETE

750 Ft. from N. Line


____ Ft. from S. Line

____ Ft. from E. Line

1120 Ft. from W. Line

ABANDONED

SECTION PLAT

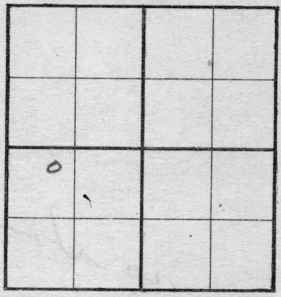

Location ____

Rig up ____

Drilling and Remarks:

RECORD

Cased ____ in., ____ ft.

Sand ____

Gas ____

Oil ____

Total Depth 600'

PRODUCTION

1st 24 hrs. Nat. ____

1st 24 hrs. after shot ____

Gas ____ Cu. Ft.

Dry Hole ____

Abandoned ✓

Date

SEP 17 1930

19

CHAS. L. SHERWOOD

Scout