
Coffey

Form 51—5M 2-29-34703

Map No. KANSAS Sec. 32 Twp. 22 R. 15E

Well No. 1 Hay Farm

R.A. Roberts Company

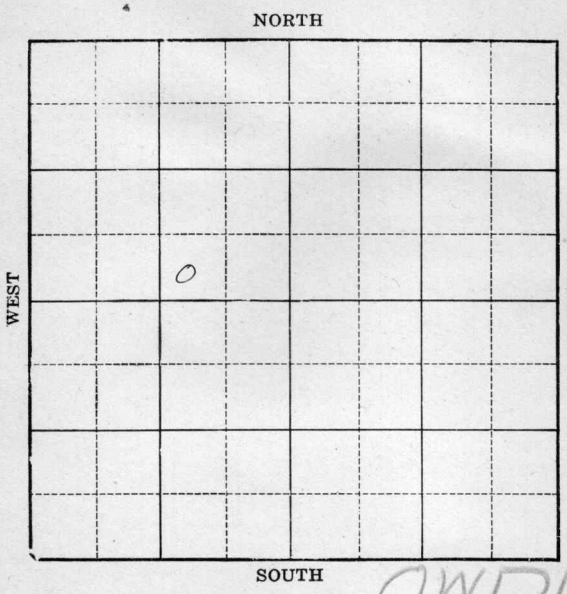

OWDD

Location

Drilling Remarks

Rig Up

Drilling Remarks

RECORD

Cased in. ft.

Sand

Gas

Oil

Total Depth

PRODUCTION

1st 24 hrs. Nat.

1st 24 hrs. after shot

Gas cu. ft.

Dry Hole

Abandoned


Coffey

Form 252A—5M—11-29—38055

Map No. KANSAS Sec. 32 Twp. 22 R. 15 E

Well No. 1 Fay Farm

R. A. Roberts Company

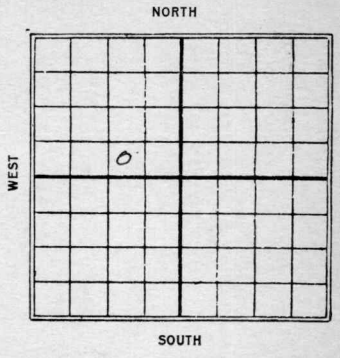

Ft. from N. Line

250 Ft. from S. Line

1120 Ft. from E. Line

Ft. from W. Line

1930

Date	REPORT
5/21	Machine
5/28	Rigg up
6/4	—
6/11	—
6/18	—
6/25	Spdg. 220'
7/2	Drlg. 820'
7/9	Tsd. 885'
7/16	Drlg. 950'
7/23	" 1100'
7/30	Tsg. 8" — 1100'
8/6	—
8/13	—
8/20	—
8/27	—
9/3	—
9/11	—
9/17	dry 1125'
9/24	—
10/1	—
10/8	T.D. 1125
	dry & abandon

(over) 10WDD

1930 OWDD
11/5- Old TD 1125
dry 1250'
11/12- —
11/19 —
11/19- S.D. 1250'
11/26 —
12/3 —
12/10 —
12/17 —
12/23 —
12/30 —
1931
1/7 —
1/14 —
1/21 —
1/28 —
2/4 —
2/11 —
2/18 —
2/25 —
3/4 —
3/11 —
3/18 —
3/25 —
4/1 —
4/8 — 1931
4/15 — 6/3 T.D. 1250
4/22 — dry & Abandon
4/29 —
5/6 —
5/13 —
5/20 —
5/27 —

Form 26—1M Bks.—2-29

Coffey

Map No. KANSAS Sec. 32 Twp. 22 R. 15 E

20

Well No. 1 Hay

R. a. Roberts Company

Contractor

FIRST REPORTS


____ Ft. from N. Line

750 Ft. from S. Line

1120 Ft. from E. Line

____ Ft. from W. Line

SECTION PLAT

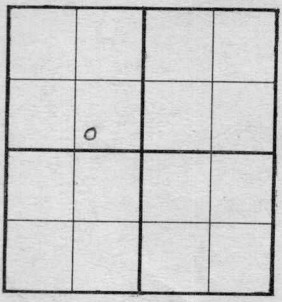

Location ____

Rig up Machine

Drilling and Remarks:

RECORD

Cased ____ in., ____ ft.

Sand ____

Gas ____

Oil ____

Total Depth ____

PRODUCTION

1st 24 hrs. Nat. ____

1st 24 hrs. after shot ____

Gas ____ Cu. Ft.

Dry Hole ____

Abandoned ____

Date

MAY 21 1930

CHAS. L. SHERWOOD

19 ____ Scout

Form 26—1M Bks.—9-28

Coffey

Map No. ..... Sec. 32 Twp. 22 R. 15

20

Well No. 1 Hay

R. a. Roberts ..... Company

..... Contractor

COMPLETE

..... Ft. from N. Line


750 Ft. from S. Line

1120 Ft. from E. Line

..... Ft. from W. Line

ABANDONED

SECTION PLAT

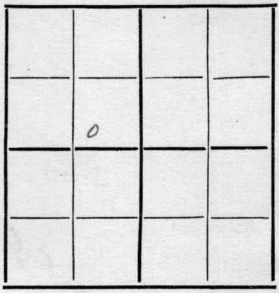

Location .....

Rig up .....

Drilling and Remarks:

RECORD

Cased ..... in., ... ft.

Sand .....

Gas .....

Oil .....

Total Depth 1125

PRODUCTION

1st 24 hrs. Nat. .....

1st 24 hrs. after shot .....

Gas ..... Cu. Ft.

Dry Hole .....

Abandoned ✓

Date

OCT 8 1930 192 CHAS. L. SHERWOOD Scout

Form 26—1M Bks.—9-28

Coffey

E

KANSAS

Map No. ..... Sec. 32 Twp. 22 R. 15

20

Well No. 1 Hay

R. a. Roberts Company

..... Contractor

FIRST REPORTS

..... Ft. from N. Line


750 Ft. from S. Line

1120 Ft. from E. Line

..... Ft. from W. Line

"Old hole Deeper"

SECTION PLAT

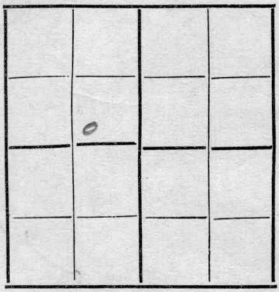

Location .....

Rig up ID was 1125

Drilling and Remarks:

Dg 1750'

RECORD

Cased ..... in., ... ft.

Sand .....

Gas .....

Oil .....

Total Depth .....

PRODUCTION

1st 24 hrs. Nat. .....

1st 24 hrs. after shot .....

Gas ..... Cu. Ft.

Dry Hole .....

Abandoned .....

Date

NOV 5 1930 CHAS. L. SHERWOOD

..... 192 ..... Scout

Form 26—1M Bks.—9-26

KANSAS

Coppey

Map No. 20 Sec. 32 Twp. 22 R. 15 E


Well No. 1 Hay

R. a. Roberts Company

Contractor

COMPLETED

SECTION PLAT

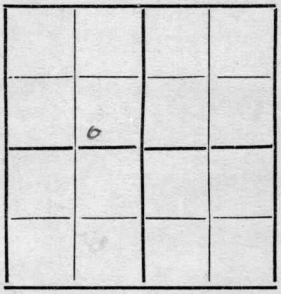

Ft. from N. Line

750 Ft. from S. Line

1170 Ft. from E. Line

Ft. from W. Line

ABANDONED

Location

Rig up

Drilling and Remarks:

RECORD

Cased in., ft.

Sand

Gas

Oil

Total Depth 1750

PRODUCTION

1st 24 hrs. Nat.

1st 24 hrs. after shot

Gas Cu. Ft.

Dry Hole ✓

Abandoned ✓

Date

JUN 3 1931

192

CHAS. L. SHERWOOD

Scout