


Coffey

Map No. Kans Sec. 17 Twp. 22 R. 17
Well No. 1 Volland Farm
McGinnis et al Company

NORTH

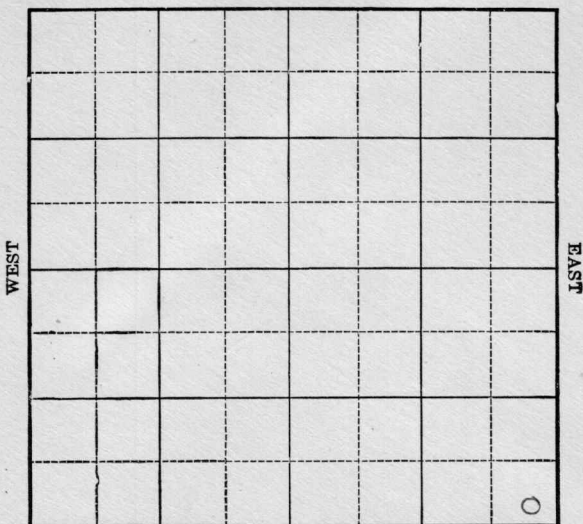

SOUTH

Location _____

Drilling Remarks

Rig Up _____

Drilling Remarks

RECORD

Cased _____ in. _____ ft.

Sand _____

Gas _____

Oil _____

Total Depth _____

PRODUCTION

1st 24 hrs. Nat. _____

1st 24 hrs. after shot _____

Gas _____ cu. ft.

Dry Hole _____


Abandoned _____

Map No. *Kan* Sec. *17* Twp. *22* R. *17*Well No. *1* *Volland* Farm*McGinnis et al* Company

Ft. from N. Line

350 Ft. from S. Line*250* Ft. from E. Line

Ft. from W. Line

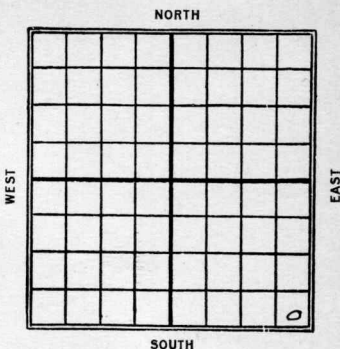*1926*

Date

REPORT

9/15 Spudding
9/22 same
9/29 same
10/3 S.D. 775
10/27 same
11/11 same
11/17 same
11/23
12/8 sand 96.5-80' 5 bbl sho.
WR.
12/15 Drlg 1200'
12/22 " 1300
12/30 same
1927
1/6 sand 96.5-80-5 bbl
D.O.A. 1430

no map
KANSAS
 Map No. 1 Sec. 17 Twp. 22 R. 17
 Well No. 1 *Solland*
McSinnis et al Company

Contractor

FIRST REPORTS

_____ Ft. from N. Line

250 _____ Ft. from S. Line

250 _____ Ft. from E. Line

_____ Ft. from W. Line

SECTION PLAT

Location _____

Rig up _____

Drilling and Remarks:

Spudding

RECORD

Cased _____ in., _____ ft.

Sand _____

Gas _____

Oil _____

Total Depth _____

PRODUCTION

1st 24 hrs. Nat. _____

1st 24 hrs. after shot _____

Gas _____ Cu. Ft.

Dry Hole _____

Abandoned _____

Date

SEP 15 1926

CHAS. L. SHERWOOD

192

Scout

Coffey

KANSAS
 Map No. *17* Sec. *22* Twp. *17*
 Well No. *1 Holland*
Mc Ginnis et al Company

COMPLETED

SECTION PLAT

_____ Ft. from N. Line

250 _____ Ft. from S. Line

250 _____ Ft. from E. Line

_____ Ft. from W. Line

ABANDONED

Location _____

Rig up _____

Drilling and Remarks:

Strat 965-80' 5' B&S
show

RECORD

Cased _____ in., _____ ft.

Sand _____

Gas _____

Oil _____

Total Depth *1430*

PRODUCTION

1st 24 hrs. Nat. _____

1st 24 hrs. after shot _____

Gas _____ Cu. Ft.

Dry Hole ☒

Abandoned ☒

Date
 JAN 6 1927

CHAS. L. SHERWOOD