


Map No. Kansas Sec. 18 Twp. 22 R. 18
 Well No. 1 Wore Farm
John E. Wells et al Company

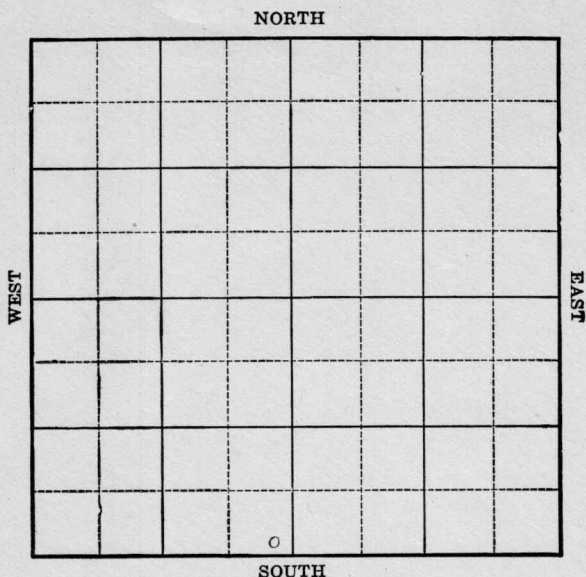

Location _____
 Drilling Remarks _____

Rig Up _____
 Drilling Remarks _____

RECORD

Cased _____ in. _____ ft.
 Sand _____
 Gas _____
 Oil _____
 Total Depth _____

PRODUCTION

1st 24 hrs. Nat. _____
 1st 24 hrs. after shot _____
 Gas _____ cu. ft.
 Dry Hole _____
 Abandoned _____


Anderson

Map No. Kansas Sec. 18 Twp. 22 R 18Well No. 1 Wore Farm
John E. Wells et al Company

Ft. from N. Line

250 Ft. from S. Line250 Ft. from E. Line

Ft. from W. Line

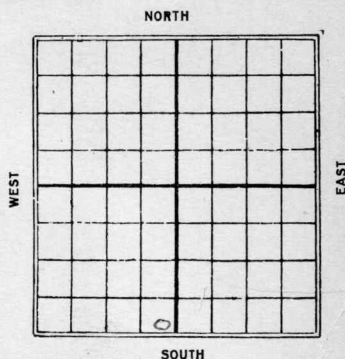

Date

REPORT

1926

9/1 Top Miss line 1305
6" 1305'
1st break 1325
Sand 1147-1277 Dry
T.D. 1367
D. & A. 1367 S.L.M.

no map
 Map No. KANSAS Sec. 18 Twp. 22 R. 18
 Well No. John E. Wells et al Company _____

FIRST REPORT

Contractor _____

COMPLETED

SECTION PLAT

_____ Ft. from N. Line

250 Ft. from S. Line

250 Ft. from E. Line

_____ Ft. from W. Line

ABANDONED

Dealey Contract

Location _____

Rig up _____

Drilling and Remarks:

*Tap near line 305
 6" 1305'
 1st break 1325'
 DQ 1367' HFM
 S.H.M.*

RECORD

Cased _____ in., _____ ft.
 Sand 1147-1277 Day
 Gas _____
 Oil _____
 Total Depth 1367'

PRODUCTION

1st 24 hrs. Nat. _____
 1st 24 hrs. after shot _____
 Gas _____ Cu. Ft.
 Dry Hole ☒
 Abandoned ☒

Date

SEP 1 1926

CHAS. L. SHERWOOD

192

Scout