

Map No. *Bottle* **KANSAS** Sec. *11* Twp. *24*^{*5*} R. *4E*

Well No. *1- Scully* Farm
Phillips Oil Company

NORTH

WEST	<i>0</i>							

EAST

SOUTH

Location.....

Drilling Remarks

Rig Up.....

Drilling Remarks

RECORD

Cased.....in.....ft.

Sand.....

Gas.....

Oil.....

Total Depth.....

PRODUCTION

1st 24 hrs. Nat.....

1st 24 hrs. after shot.....

Gas.....cu. ft.....

Dry Hole.....

Abandoned.....

Map No. Sec. Twp. R.

Well No. Farm


..... Company

..... Ft. from N. Line

..... Ft. from S. Line

..... Ft. from E. Line

..... Ft. from W. Line

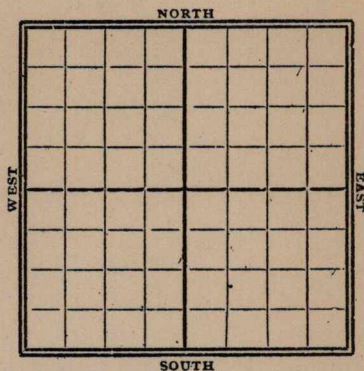

1923

Date

REPORT

Gypsy Records

5/16

Abel T.D. 2590'

MAP NO. 1514 **KANSAS** SEC. 11 TWP. 24S 4E

WELL NO. 1 Scully

Phillips Pet. COMPANY

CONTRACTOR

SECTION PLAT

ABANDONED

_____ FT. FROM N. LINE

_____ FT. FROM S. LINE

_____ FT. FROM E. LINE

_____ FT. FROM W. LINE

0			

RECORD

LOCATION _____

CASED _____ IN. _____ FT.

RIG UP _____

SAND _____

DRILLING AND REMARKS:

GAS _____

OIL _____

TOTAL DEPTH 2590

PRODUCTION

1ST 24 HRS. NAT. _____

1ST 24 HRS. AFTER SHOT _____

GAS _____ CU. FT.

DRY HOLE ☒

ABANDONED ☒

DATE

5/16 192 3 SCOUT