FORM 51 10M 8-47

KANSAS


aHarvey

Section 3 Township 23 Range 1E

Well No. #1 Sauder

Company Bay Pet

Wildcat

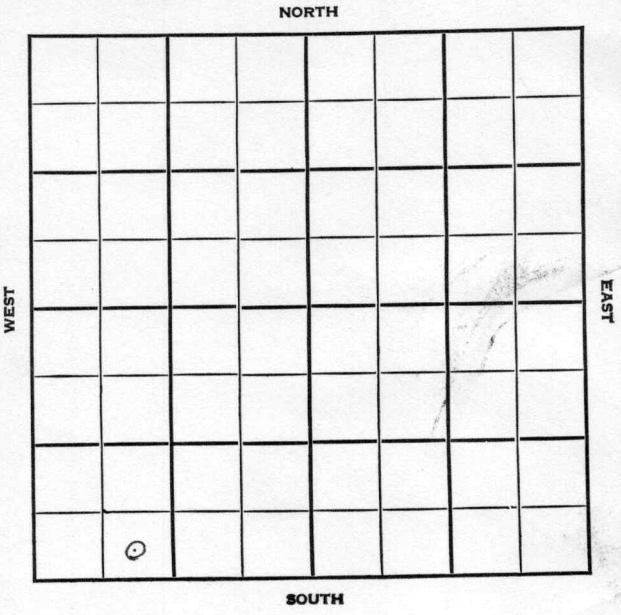

FORM 252-A
5M 12-45 PETROL

KANSAS Harvey

Sec. 3 Twp. 23 R. 1E

Well No. #1 Sauder Farm

Bay Pet. Company

Wildcat


____ Ft. from N. Line

330 Ft. from S. Line

____ Ft. from E. Line

990 Ft. from W. Line

SE SW SW

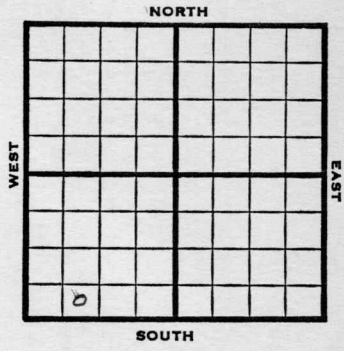

REPORT

1948 Elev. 1465'

4/14 8" @ 260'
Drlg. 496'

4/21 "

4/28 Hunton 3380'
Viola 3473'
Simp 3509'
Arb. 3591'
TD 3622 '

ABANDONED

Form 26—200 Bks.—1-48—Palace

Wildcat

Kansas

Map No. _____ Sec. 3 Twp. 23 R. 1E


Well No. 1 Sauder

Bay Pet. Company

FIRST REPORT Contractor

SE SW SW

SECTION PLAT

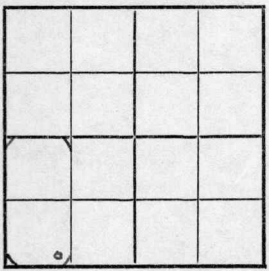

_____ Ft. from N. Line

330 Ft. from S. Line

_____ Ft. from E. Line

990 Ft. from W. Line

Harvey County

Location _____

Rig up _____

Drilling and Remarks:

8"@ 260

drlg. 496

RECORD

Cased _____ in., _____ ft.

Sand _____

Gas _____

Oil _____

Total Depth _____

PRODUCTION

1st 24 hrs. Nat. _____

1st 24 hrs. after shot _____

Gas _____ Cu. Ft.

Dry Hole _____

Abandoned _____

Date

APR 1 4 1948 19____ S. J. LEWIS Scout

Form 26—200 Bks.—1-48—Palace

Wildcat

Kansas

Map No. 13 Sec. 3 Twp. 23 R. 1E

Well No. 1 Sauder


Bay Pet. Company

ABANDONED Contractor

SE SW SW

E 1,1465

SECTION PLAT

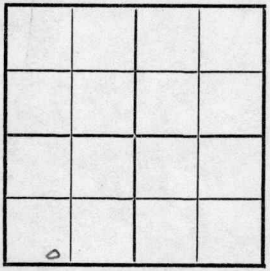

____ Ft. from N. Line

330 Ft. from S. Line

____ Ft. from E. Line

990 Ft. from W. Line

Harvey County

Location

Rig up

Drilling and Remarks:

Hunton 3380
Viola 3428
Simp 3509
Arb 3591

RECORD

Cased ____ in., ____ ft.

Sand

Gas

Oil

Total Depth 3622

PRODUCTION

1st 24 hrs. Nat.

1st 24 hrs. after shot.

Gas Cu. Ft.

Dry Hole

Abandoned

Date

APR 2 8 1948 19____ S. J. LEWIS Scout