


Section 8 Township 24 Range 4EWell No. 1 KasenbergCompany White & Ellis et al

NORTH

WEST

EAST

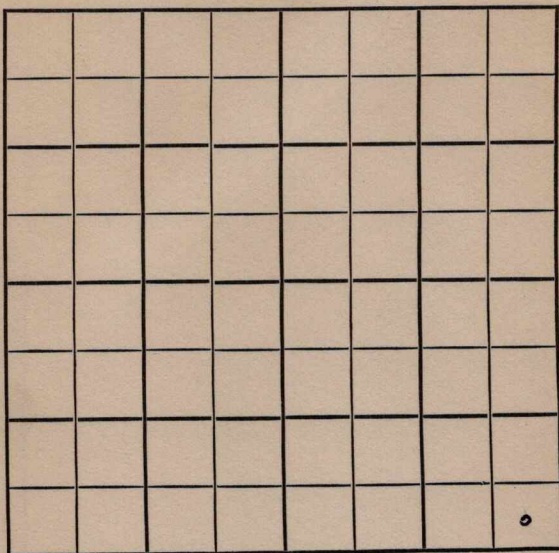

SOUTH

Butler

KANSAS

SEC.	TWP.	R.
8	24	4 E

WELL NO.

1 Kasenberg

FARM

COMPANY

White & Ellis et al

CONTRACTOR

White & Ellis

Semi-Wildcat


Ft. from N. Line

330 Ft. from S. Line

330 Ft. from E. Line

Ft. from W. Line

SE SESE

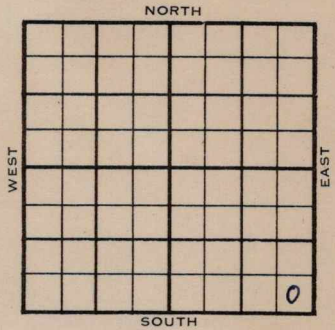

ELEVATION

REPORT

1954

5/26

Spud 5-23-54

Setting surface pipe.

6/2

Spudding 5-23-54

D & A TD 2642

8" @ 96 Lans. 1858 KC 2158

Miss. 2558

TD 2642 D & A

ABANDONED

County Butler State KansasSec. 8 (Blk.
Twp.) 24 (Sur.
Rge.) 4E Map No.Operator White & Ellis etal.Well No. 1 Farm KasenbergElev. Location SE SE SE330 Ft. From S Line SE330 Ft. From E Line Quarter

1st. Report

Completion JUN 2 1954Remarks SemiWildcatWhite & Ellis - Contr.Spudding Date 5-23-54Drlg. Data D & A TD 26428" @ 96 Lens. 1858 KC 2158Miss. 2558 TD 2642D & A

J. G. McGEHEE