


Map No. _____ Sec. 30 Twp. 22 R. 13
Well No. 1-Wingeler Farm _____
Parobb Oil Co Company _____

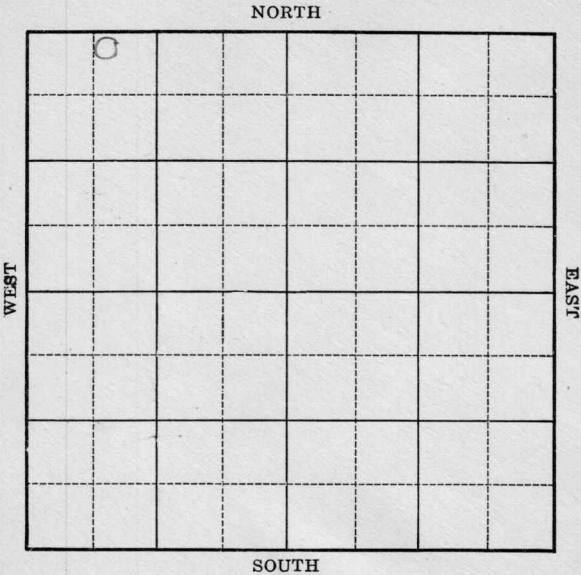

Location _____
Drilling Remarks _____

Rig Up _____
Drilling Remarks _____

RECORD

Cased _____ in. _____ ft.
Sand _____
Gas _____
Oil _____
Total Depth _____

PRODUCTION

1st 24 hrs. Nat. _____
1st 24 hrs. after shot _____
Gas _____ cu. ft.
Dry Hole _____
Abandoned _____

Shenwood
 Map No. *30* Sec. *22* Twp. *13* R. *13* ^E

Well No. *1 Winger*
Harold Oil Co Company

Contractor

lot 47 - north.
Hamont Township.

SECTION PLAT

280 Ft. from N. Line

_____ Ft. from S. Line

_____ Ft. from E. Line

696 Ft. from W. Line

FIRST REPORTS

Location _____

Rig up _____

Drilling and Remarks:

Rigging up Machine

RECORD

Cased _____ in., _____ ft.

Sand _____

Gas _____

Oil _____

Total Depth _____

PRODUCTION

1st 24 hrs. Nat. _____

1st 24 hrs. after shot _____

Gas _____ Cu. Ft.

Dry Hole _____

Abandoned _____

Date

Oct 26 1927

192

CHAS. L. SHERWOOD

Scout

Map No. *map* Sec. *30* Twp. *22* R. *13*

Well No. *1 Winger*
Larabie Oil Co Company

Contractor

COMPLETED

SECTION PLAT

ABANDONED

280 Ft. from N. Line

Ft. from S. Line

Ft. from E. Line

696 Ft. from W. Line

Lot 47- Homestead Township

Location

Rig up

Drilling and Remarks:

S & A
1775'

RECORD

Cased *1680-1775* in., ft.
 Sandy *Shale*
 Gas
 Oil
 Total Depth *1775'*

PRODUCTION

1st 24 hrs. Nat. _____
 1st 24 hrs. after shot _____
 Gas _____ Cu. Ft.
 Dry Hole ☒
 Abandoned ☒

Date

NOV 23 1927

192

CHAS. L. SHERWOOD

Scout