
Greenwood

Form 51—5M—1-30—38840

Map No. KANSAS Sec. 32 Twp. 22 R. 13E

Well No. 1 Davis Farm

Parish Gas Company

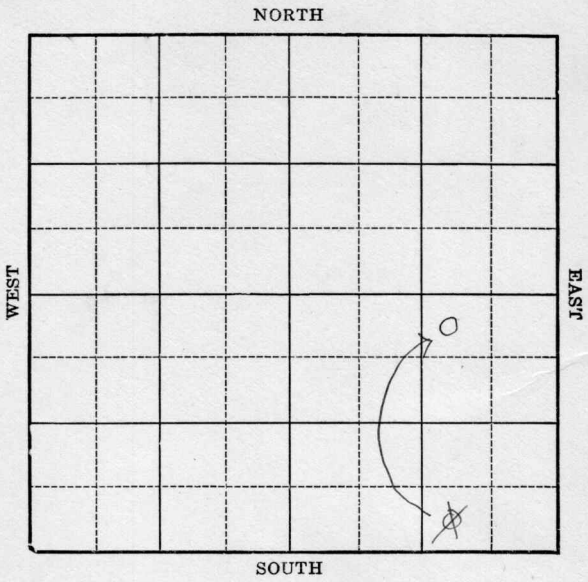

Location

Drilling Remarks

Rig Up

Drilling Remarks

RECORD

Cased ____ in. ____ ft.

Sand

Gas

Oil

Total Depth

PRODUCTION

1st 24 hrs. Nat.

1st 24 hrs. after shot

Gas ____ cu. ft.

Dry Hole

Abandoned

Greenwood

FORM 252A-5M-8-30-PETROL

Map No. KANSAS Sec. 32 Twp. 22 R. 13E

Well No. 1 Davis Farm

Parish etal Company


330 Ft. from N. Line

330 Ft. from S. Line

990 Ft. from E. Line

Ft. from W. Line

1931

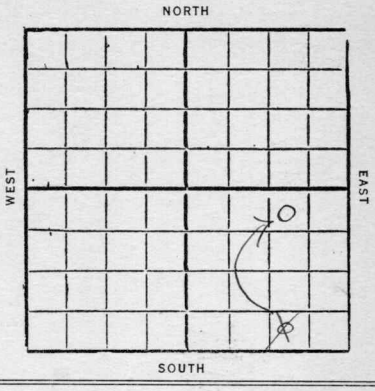

Date	REPORT
2/25	Loc
3/4	
3/11	
3/18	Run up
3/25	Drlg 300'
4/1	SD 300'
4/8	
4/15	Drlg 720'
4/22	" @ 1042'
4/29	Top lime 1815'
	T.D. 1833' HFW
	Dry & Abandon

Form 26—1M Bks.—9-28

Greenwood 70


Map No. KANSAS Sec. 32 Twp. 22 R. 13E

Well No. 1 Davis

Parish Et al Company

Contractor

SECTION PLAT

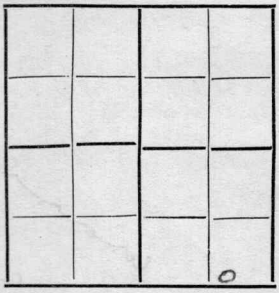

Ft. from N. Line

330 Ft. from S. Line

990 Ft. from E. Line

Ft. from W. Line

FIRST REPORTS

Location

Rig up

Drilling and Remarks:

RECORD

Cased in., ft.

Sand

Gas

Oil

Total Depth

PRODUCTION

1st 24 hrs. Nat.

1st 24 hrs. after shot

Gas Cu. Ft.

Dry Hole

Abandoned

Date

FEB 25 1931

192 . S. J. LEWIS Scout

Form 26—1M Bks.—9-28

Greenwood

Map No. KANSAS Sec. 32 Twp. 22 R. 13E


20

Well No. 1 Harris

Parrish & Dale Company

Contractor

SECTION PLAT

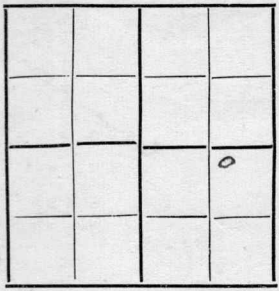

330 Ft. from N. Line

Ft. from S. Line

990 Ft. from E. Line

Ft. from W. Line

CORRECTION

Location

Rig up

Drilling and Remarks:

Reported

Gypsum.

RECORD

Cased in., ft.

Sand

Gas

Oil

Total Depth

PRODUCTION

1st 24 hrs. Nat.

1st 24 hrs. after shot

Gas Cu. Ft.

Dry Hole

Abandoned

Date

MAR 25 1931 192

S. J. LEWIS Scout

Form 26—1M Bks.—9-26

Greenwood

20

Map No. KANSAS Sec. 32 Twp. 22 R. 13 E

Well No. 1 Davis

Parrish et al Company

Contractor

COMPLETE

300 Ft. from N. Line


Ft. from S. Line

1085 Ft. from E. Line

Ft. from W. Line

ABANDONED

SECTION PLAT

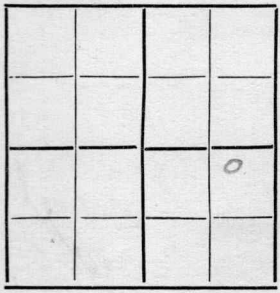

Location

Rig up

Drilling and Remarks:

Top Lime 1815

HFW 1833

RECORD

Cased in., ft.

Sand

Gas

Oil

Total Depth 1833

PRODUCTION

1st 24 hrs. Nat.

1st 24 hrs. after shot

Gas Cu. Ft.

Dry Hole ✓

Abandoned

Date

APR 29 1931

192 CHAS. L. SHERWOOD Scout