


Form 51-5M-3-35-Mid-West

Map No. KANSAS Sec. 33 Twp. 22 R. 13-E
 Well No. #1-Gruber Farm
Absher et al Company

NORTH

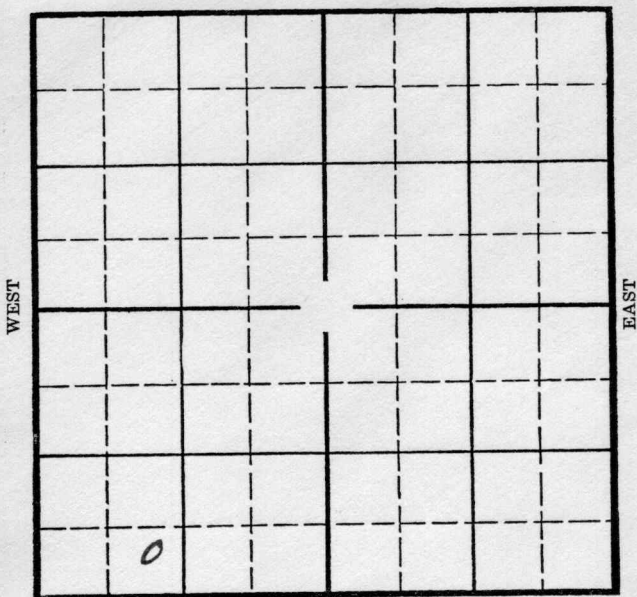

SOUTH

Location.....

Drilling Remarks.....

.....

.....

.....

.....

.....

.....

.....

.....

.....

.....

RECORD

Cased..... in. ft.

Sand.....

Gas.....

Oil.....

Total Depth.....

Rig Up.....

Drilling Remarks.....

.....

.....

.....

.....

.....

.....

.....

.....

.....

.....

PRODUCTION

1st 24 hrs. Nat.....

1st 24 hrs. after shot.....


Gas..... cu. ft.

Dry Hole.....

Abandoned.....

Map No. KANSAS Sec. 33 Twp. 22 R. 13E
Well No. 1- Huber Farm
Absher oil Company

Ft. from N. Line
300 Ft. from S. Line
Ft. from E. Line
1070 Ft. from W. Line

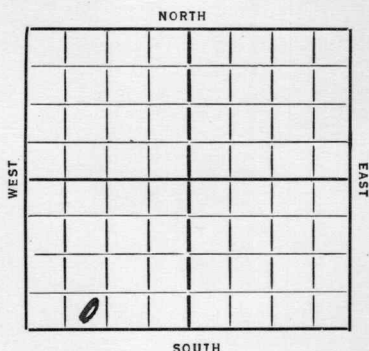

REPORT

Date	Location
<u>2/26</u>	
<u>2/27</u>	
<u>2/28</u>	<u>M. J. Guch</u>
<u>3/6</u>	<u>Spur</u>
<u>3/13</u>	--
<u>3/20</u>	Drlg. 300' [CORRECTION- DRILLING 100']
<u>3/27</u>	Drlg. 100'
<u>4/2</u>	Drlg. 950'
<u>4/10</u>	Shut down.
<u>4/16</u>	Drlg. 1100'
<u>4/23</u>	S.D.
<u>4/30</u>	Drlg. 1310'.
<u>5/7</u>	S.D.
<u>5/14</u>	Sand 1652-1708'. 1708'. T.D. 1709'. 5 bbls oil 75 bbls water in 12 hrs.
<u>5/21</u>	Under reaming 5".
<u>5/28</u>	1715' fishing.
<u>6/4--6/11--6/18--6/25--</u>	x/x
<u>7/2</u>	Drilling by tools.
<u>7/9</u>	--7/16--7/23--
<u>7/30</u>	--
<u>8/6</u>	Shut down.

OVER

8/12/36-T.D. 1715'.

Dry and abandoned.

ABANDONED

KANSAS

Map No. 20 Sec. 33 Twp. 22 R. 12EWell No. 1 GunterAtcher & Co Company

Contractor

SECTION PLAT

 Ft. from N. Line300 Ft. from S. Line Ft. from E. Line1070 Ft. from W. Line

ABANDONED

Location Rig up

Drilling and Remarks:

DSH

RECORD

Cased in., ft.Sand Gas Oil Total Depth 1715

PRODUCTION

1st 24 hrs. Nat. 1st 24 hrs. after shot Gas Cu. Ft.Dry Hole Abandoned

Date

AUG 12 1936 19S. J. LEWIS Scout