

Kansas

STATE

Graham

COUNTY

Graham

BLOCK

SEC.

19

T.

6

R.

25W

ALTITUDE

2602

PRODUCTION

D4A

COMPANY

Hall-Jones & Benson

FARM

Bradley-Selms

WELL NO.

1

SURVEY

TOTAL DEPTH

4200'

SW-NW-NE

COMMENCED


COMPLETED

REMARKS

CASING RECORD  
DST 2758-78/1hr  
50' Mud (sl. oil sept.)  
BNP 1025#.

SHOT QUARTS BETWEEN

FORM 186 - In stock and for sale by Ross-Martin Co., Tulsa

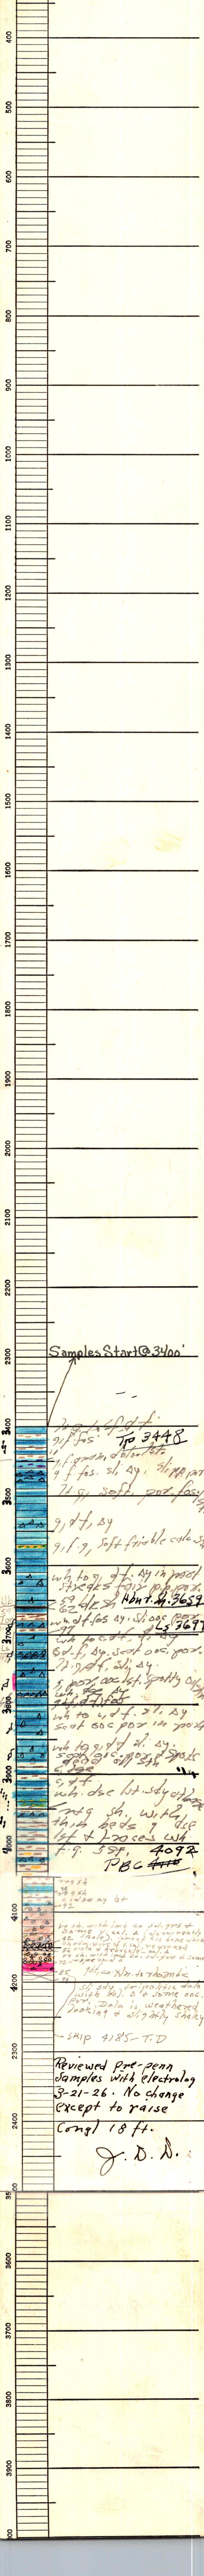

Reviewed pre-penn samples with electrolog 3-21-26. No change except to raise Congl 18 ft. J. D. D.