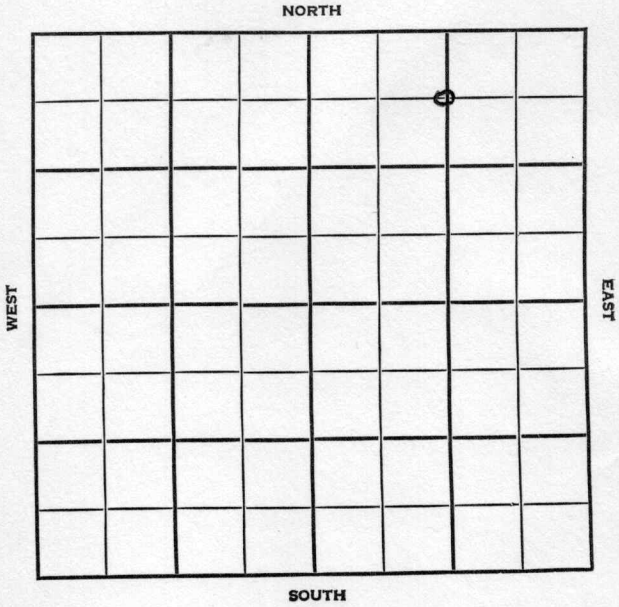


DX 78-1

Section 32 Township 22 Range 13EWell No. 3 WernliCompany Geo. Sheenan

Greenwood

KANSAS

SEC.	TWP.	R.
32	22	13 E ✓

WELL NO.

3 Wernli

FARM

COMPANY

Geo. Scheehan

CONTRACTOR

Jackman & Jackman


Lamont Pool

660 Ft. from N. Line

Ft. from S. Line

1320 Ft. from E. Line

Ft. from W. Line

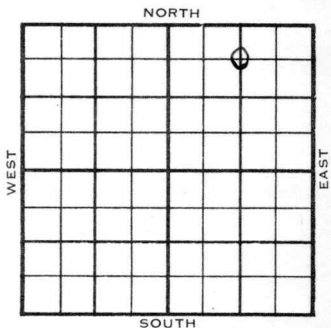C N $\frac{1}{2}$ NE

ELEVATION

REPORT

1954

-

5/26

MIR

6/9

Spud 5-25-54
8" @ 64'
Bart 1740'
TD 1755'
D&A

ABANDONED

County Greenwood State KansasSec. 32 (Blk.) 22 (Sur.) 13E Map No.Operator Geo. SheehanWell No. 3 Farm WernliElev. _____ Location C N $\frac{1}{2}$ NE

FIRST REPORT

660 Ft. From N Line NE1320 Ft. From E Line Quarter1st. Report MAY 26 1954

Completion _____

Remarks _____

Jackman & Jackman - Contr.

Spudding Date _____

Drlg. Data Lamont PoolM I R

County Greenwood State KansasSec. 32 (Bk.
Twp.) 22 (Sur.
Rge.) 13E Map No.Operator Geo. SheehanWell No. 3 Farm WernliElev. Location C N $\frac{1}{2}$ NE660 Ft. From N Line NE1320 Ft. From E Line Quarter1st. ReportCompletion JUN 9 1954Remarks Lamont PoolJackman & Jackman - Contr.Spudding Date 5-25-54Drlg. Data8" @ 64 Bart. 1740 TD 1755 D & A