

STATE
Kansas

COUNTY
Hodgeman

BLOCK

COMPANY
Addis

FARM
Hoss

WELL NO.
1

SEC.
1

T. *21S* R. *25W*

COMPLETED

REMARKS
Elog!

ALTITUDE
2337.6

PRODUCTION
D.A.


CASING RECORD

SHOT QUARTS BETWEEN

186

TULSA, OKLAHOMA 74101

PRINTED IN U.S.A.

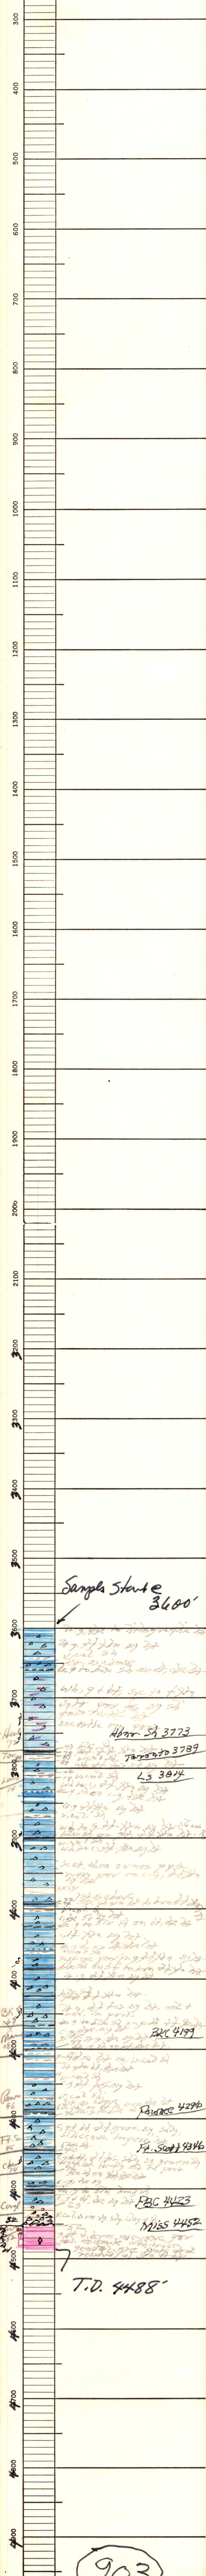

903