


Map No. _____ Sec. 34 Twp. 22 R. 13
Well No. 3 Esslinger Farm _____
Hazlett E. Pal Company _____
(Esslinger)

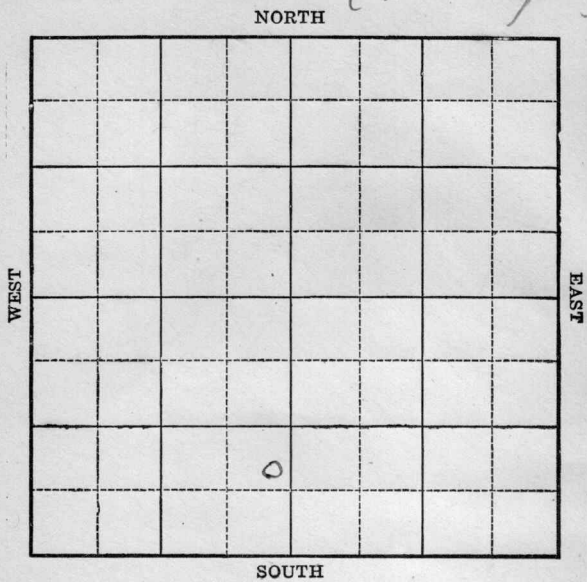

Location _____

Drilling Remarks:

RECORD

Cased _____ in. _____ ft.

Sand _____

Gas _____

Oil _____

Total Depth _____

Rig up _____

Drilling Remarks:

PRODUCTION

1st 24 hrs Nat. _____

1st 24 hrs. after shot _____

Gas _____ cu. ft.

Dry Hole _____


Abandoned _____

Map No. _____ Sec. 34 Twp. 22 R. 13Well No. 3 Eslinger Farm
Hazlett Etal Company

_____ Ft. from N. Line

760 Ft. from S. Line200 Ft. from E. Line

_____ Ft. from W. Line

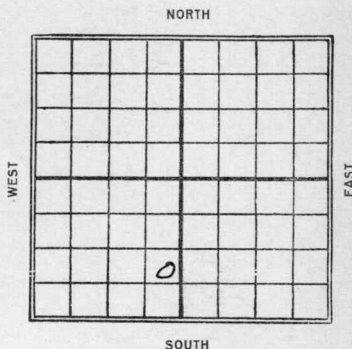

Date

REPORT

1923

1/12 Rig & tools.
2/24 Pay 1836-58- Shot 40
of 25 BPs.

Map No. **KANSAS** Sec. **34** Twp. **22** R. **13**
 Well No. **3** *Ealing*
Hazlett et al Company
 Contractor

FIRST REPORT

SECTION PLAT

_____ Ft. from N. Line
760 Ft. from S. Line
200 Ft. from E. Line
 _____ Ft. from W. Line

Location _____
 Rig up _____
 Drilling and Remarks:

Rig & Tool

RECORD

Cased _____ in., _____ ft.
 Sand _____
 Gas _____
 Oil _____
 Total Depth _____

PRODUCTION

1st 24 hrs. Nat. _____
 1st 24 hrs. after shot _____
 Gas _____ Cu. Ft.
 Dry Hole _____
 Abandoned _____

Date **JAN 12 1923**

Map No. **KANSAS** Sec. **34** Twp. **22** R. **13**

Well No. **3** *B. C. Slinger*

Bradford Haylett et al Company

Contractor

COMPLETED SECTION PLAT

_____ Ft. from N. Line

760 Ft. from S. Line

200 Ft. from E. Line

_____ Ft. from W. Line

Location _____

Rig up _____

Drilling and Remarks:

Tap Line
1867-
Pay 1836-58
40/25 Hb

RECORD

Cased _____ in., _____ ft.

Sand _____

Gas _____

Oil _____

Total Depth _____

PRODUCTION

1st 24 hrs. Nat. _____

1st 24 hrs. after shot _____

Gas _____ Cu. Ft.

Dry Hole _____

Abandoned _____

Date **FEB 24 1923**

M. A. BENEAR

_____ 191 _____ Scout