


Section 34 Township 23 Range 13-WWell No. #1 GarnerCompany Crown Oil

St John Pool NORTH

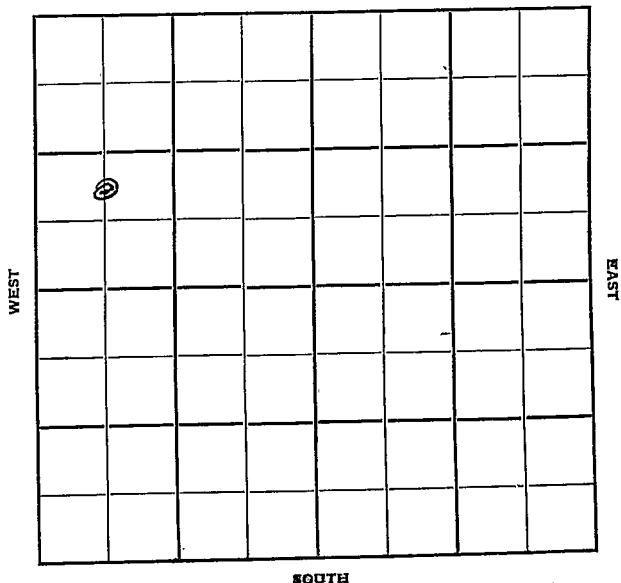

# KANSAS

Stafford

Sec. 34 Twp. 23 R. 13W ✓

Well No. 1 Garner Farm

Crown Oil Company

Crown Oil Contr. St. John Pool NORTH

~~330~~ Ft. from N. Line

990 Ft. from S. Line


Ft. from E. Line

660

~~990~~ Ft. from W. Line

~~SE SW NW~~

C N L S W N W

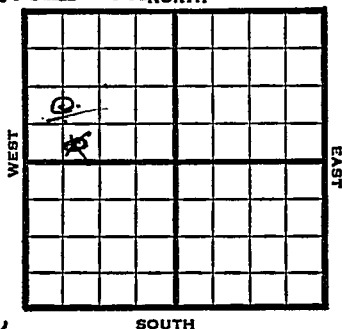

1949

Elev 1902'

R E P O R T

7/27

RUR

8/3

8" @ 295'

8/10

Drlg. 2520'

Lansing 3512'

Drlg. 3711'

8/17

TD 3942'

Arb. 3940'

Aband.

**ABANDONED.**

Kansas

St. John Pool

Map No. \_\_\_\_\_ Sec. 34 Twp. 23 R. 13W

Well No. 1 Garner

Crown Oil Company

Crown Oil Contractor

SE SW NW


FIRST REPORT  
SECTION PLAT

330 Ft. from N. Line

Ft. from S. Line

Ft. from E. Line

990 Ft. from W. Line

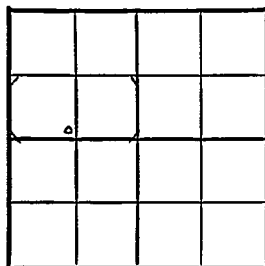

Stafford County

Location

Rig up

Drilling and Remarks:

R U R

## RECORD

Cased \_\_\_\_\_ in., \_\_\_\_\_ ft.

Sand \_\_\_\_\_

Gas \_\_\_\_\_

Oil \_\_\_\_\_

Total Depth \_\_\_\_\_

## PRODUCTION

1st 24 hrs. Nat. \_\_\_\_\_

1st 24 hrs. after shot \_\_\_\_\_

Gas \_\_\_\_\_ Cu. Ft.

Dry Hole \_\_\_\_\_

Abandoned \_\_\_\_\_

Date

JUL 27 1949 19

S. J. LEWIS Scout

St. Johns Pool

Map No. \_\_\_\_\_ Sec. 34 Twp. 23 R. 13W

Well No. 1 Garner

Crown Oil

Company

CORRECTION

Contractor

C N L SW NW

SECTION PLAT

|   |  |  |  |
|---|--|--|--|
|   |  |  |  |
| a |  |  |  |
|   |  |  |  |
|   |  |  |  |

Ft. from N. Line

990 Ft. from S. Line

Ft. from E. Line

660 Ft. from W. Line

Stafford County

Location

Rig up

Drilling and Remarks:

Reported  
SE SW NW

RECORD

Cased \_\_\_\_\_ in. \_\_\_\_\_ ft.

Sand \_\_\_\_\_

Gas \_\_\_\_\_

Oil \_\_\_\_\_

Total Depth \_\_\_\_\_

PRODUCTION

1st 24 hrs. Nat. \_\_\_\_\_

1st 24 hrs. after shot \_\_\_\_\_

Gas \_\_\_\_\_ Cu. Ft.

Dry Hole \_\_\_\_\_

Abandoned \_\_\_\_\_

Date

AUG 3 1949 19

S. J. LEWIS Scout

Kansas

Map No. 183 Sec. 34 Twp. 23 R. 13WWell No. 1 Garner


Crown Oil

Company

**ABANDONED**

Contractor

C N L SW NW

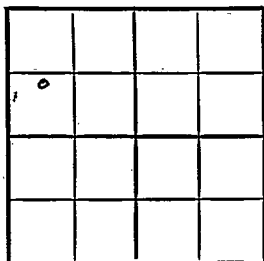*E11902.*  
**SECTION FLAT**       Ft. from N. Line000 Ft. from S. Line       Ft. from E. Line660 Ft. from W. Line

Stafford County

Location                     Rig up                     

Drilling and Remarks:

*Ac 83940***RECORD**Cased            in.,            ft.Sand                     Gas                     Oil                     Total Depth 2942**PRODUCTION**1st 24 hrs. Nat.                     1st 24 hrs. after shot                     Gas                      Cu. Ft.Dry Hole                     Abandoned                     

Date

AUG 17 1949 19S. J. LEWIS

Scout