


Map No. _____ Sec. 31 Twp. 25 R. 5Well No. 32 Robinson Farm __________Empire_____
Company

NORTH

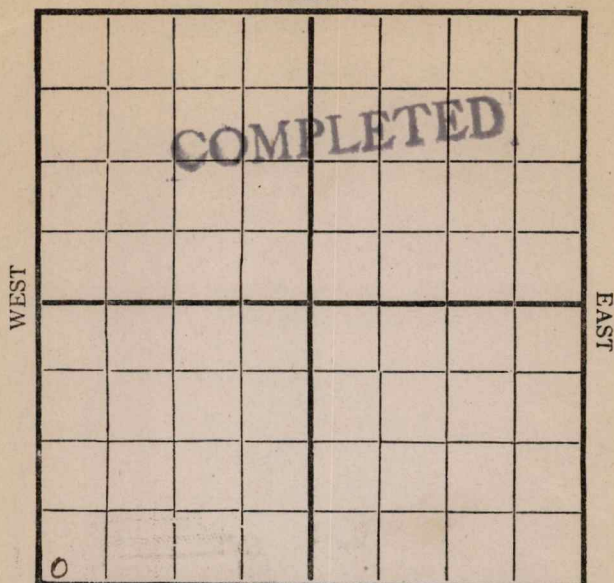

SOUTH

Location _____

Rig Up _____

Drilling Remarks:

Drilling Remarks:

RECORD

PRODUCTION

Cased _____ in _____ Ft.

1st 24 hrs. Nat. _____

Sand _____

1st 24 hrs. after shot _____

Gas _____

Gas _____ Cu. Ft.

Oil _____

Dry Hole _____

Total Depth _____


Abandoned _____

Map No. _____ Sec. 31 Twp. 25 R. 5
 Well No. 32 Robinson Farm
Engine Company

NORTH

WEST

EAST

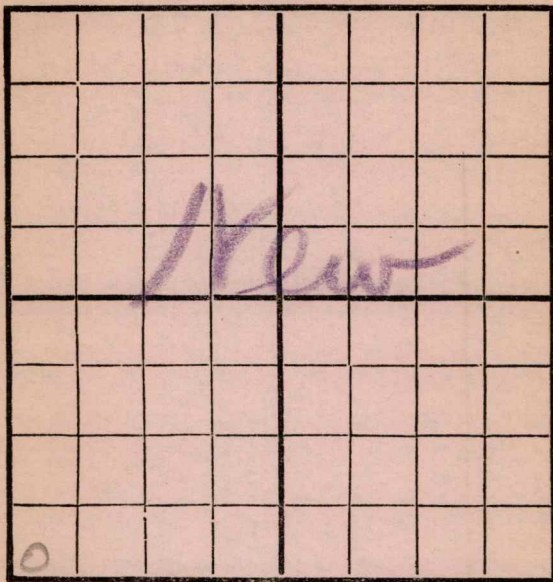

SOUTH

Location _____
 Rig Up _____
 Drilling and remarks _____

FIRST REPORT

RECORD

Cased _____ in. _____ Ft.
 Sand _____
 Gas _____
 Oil _____
 Total Depth _____

PRODUCTION

1st 24 hrs. Nat. _____
 First 24 hrs. after shot _____
 Gas _____ Cu. Ft.
 Dry Hole _____
 Abandoned _____

Date

2-5-1917 2 County Scout

Map No. _____ Sec. 31 Twp. 25 R. 5
 Well No. 32 Robinson Farm
Empire Company

NORTH

WEST

EAST

SOUTH

Location _____
 Rig Up _____
 Drilling and remarks _____

RECORD

Cased _____ in. _____ Ft.
 Sand _____
 Gas _____
 Oil _____
 Total Depth _____

PRODUCTION

1st 24 hrs. Nat. _____
 1st 24 hrs. after shot _____
 Gas _____ Cu. Ft.
 Dry Hole _____
 Abandoned _____

Date 2/9, 1917 Scout

Map No. _____ Sec. 31 Twp. 25 R. 5
 Well No. 32 Robinson Farm
Empire Company
 NORTH

WEST EAST

SOUTH

Location _____	RECORD
Rig Up ☒	Cased _____ in. _____ Ft.
Drilling and remarks	Sand _____
	Gas _____
	Oil _____
	Total Depth _____
	PRODUCTION
	1st 24 hrs. Nat. _____
	First 24 hrs. after shot _____
	Gas _____ Cu. Ft.
	Dry Hole _____
	Abandoned _____


Date Apr 26, 1917 Carney Scout

Map No. _____ Sec. 31 Twp. 25 R. 5
 Well No. 32 Robinson Farm _____
Engine Company _____

NORTH

WEST

EAST

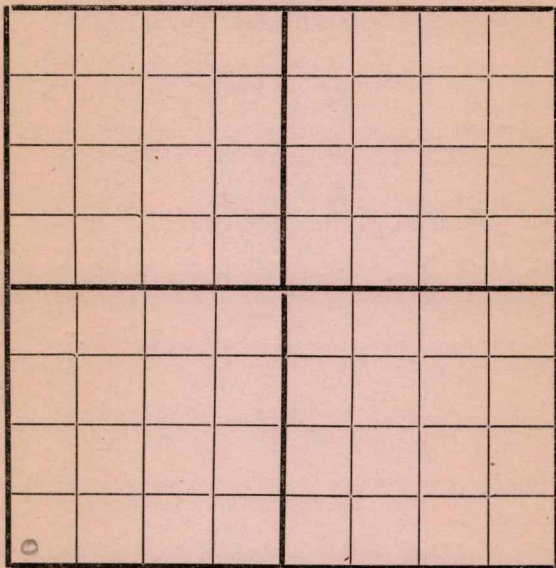

SOUTH

Location _____

Rig Up _____

Drilling and remarks _____

RECORD

Cased _____ in. _____ Ft.

Sand _____

Gas _____

Oil _____

Total Depth _____

PRODUCTION

1st 24 hrs. Nat. _____

1st 24 hrs. after shot _____

Gas _____ Cu. Ft.

Dry Hole _____


Abandoned _____

Date

3/5, 1917 Carley Scout

Map No.----- Sec. 31 Twp. 25 R. 5Well No. 32 Robinson FarmEmpire Company

NORTH

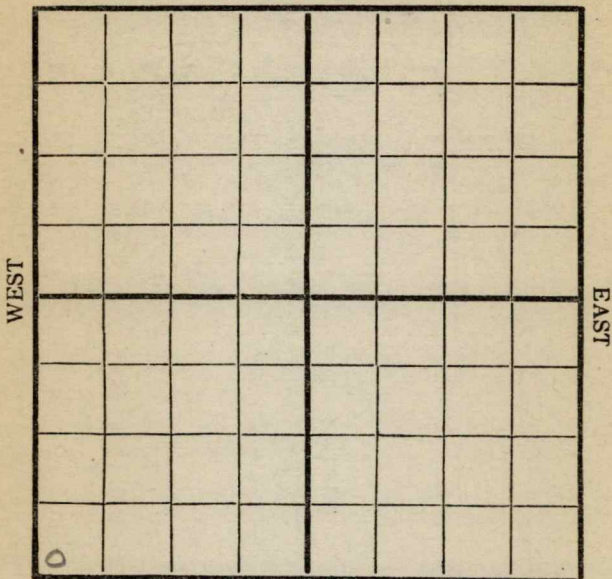

SOUTH

REMARKS:

Rig up

Date


3/2, 1912 Carly Scout

Map No. _____ Sec. 31 Twp. 25 R. 5
 Well No. 32 Robinson Farm
Engine Company

NORTH

WEST

EAST

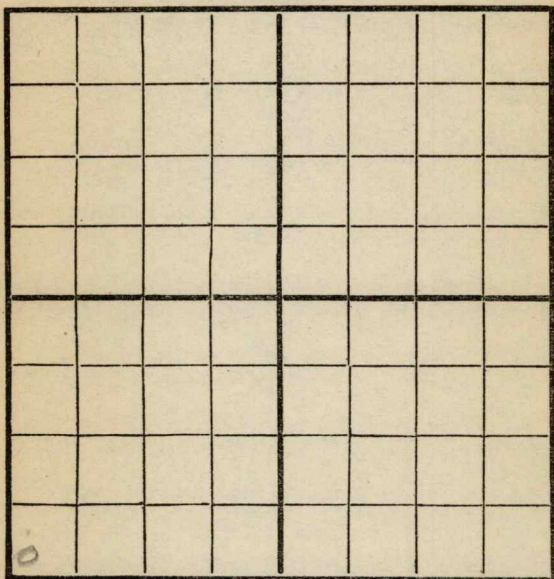

SOUTH

Location _____

Rig Up _____

Drilling and remarks _____

RECORD

Cased _____ in. _____ Ft.

Sand _____

Gas _____

Oil _____

Total Depth _____

PRODUCTION

1st 24 hrs. Nat. _____

1st 24 hrs. after shot _____

Gas _____ Cu. Ft.

Dry Hole _____

Abandoned _____

Date


3/26, 1917. C. C. C. Scout

Map No. _____ Sec. 31 Twp. 25 R. 5
 Well No. 32 Robinson Farm
Engine Company

NORTH

WEST

EAST

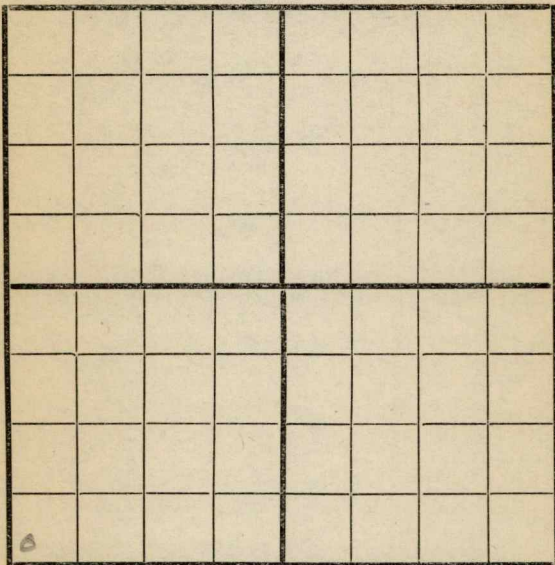

SOUTH

Location _____

Rig Up _____

Drilling and remarks _____

RECORD

Cased _____ in. _____ Ft.

Sand _____

Gas _____

Oil _____

Total Depth _____

PRODUCTION

1st 24 hrs. Nat. _____

1st 24 hrs. after shot _____

Gas _____ Cu. Ft.

Dry Hole _____

Abandoned _____

Date


4/5, 191 7 Curry Scout

Map No. _____ Sec. 31 Twp. 25 R. 5
 Well No. 32 Robinson Farm _____
Empire Company _____

NORTH

WEST

EAST

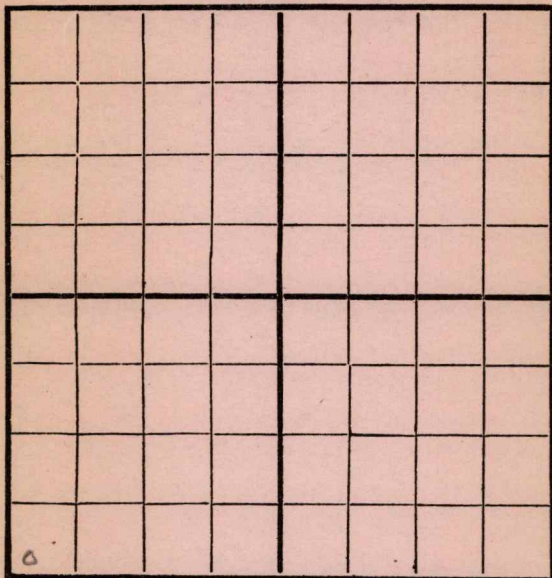

SOUTH

Location _____
 Rig Up ☒ _____
 Drilling and remarks _____

RECORD

Cased _____ in. _____ Ft.
 Sand _____
 Gas _____
 Oil _____
 Total Depth _____


PRODUCTION

1st 24 hrs. Nat. _____
 1st 24 hrs. after shot _____
 Gas _____ Cu. Ft.
 Dry Hole _____
 Abandoned _____

Date

4/11, 1917. Carroll Scout

Map No. _____ Sec. 31 Twp. 25 R. 5
Well No. 3220 Farm _____
Engine Company _____
NORTH

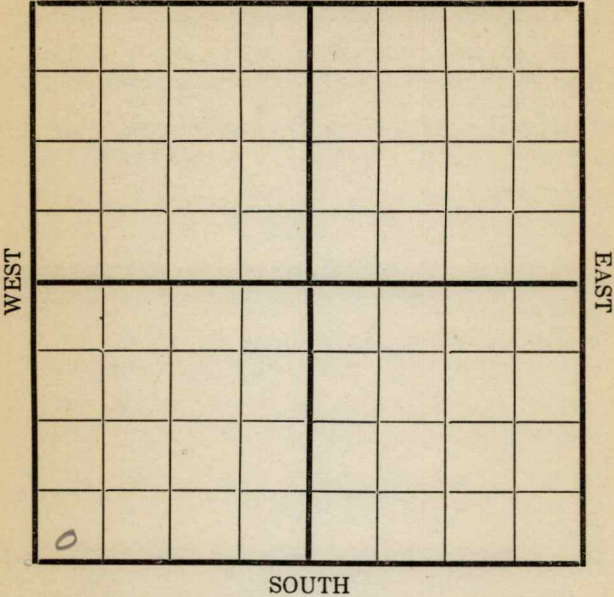

Location _____ Rig Up ☒ _____ Drilling and remarks _____	RECORD
	Cased _____ in. _____ Ft.
	Sand _____
	Gas _____
	Oil _____
	Total Depth _____
	PRODUCTION
	1st 24 hrs. Nat. _____
	1st 24 hrs. after shot _____
	Gas _____ Cu. Ft.
	Dry Hole _____
	Abandoned _____


Date 4/19, 1912 Carley Scout

Map No. _____ Sec. 31 Twp. 25 R. 5
 Well No. 32 Robinson Farm
Engine Company

NORTH

WEST

EAST

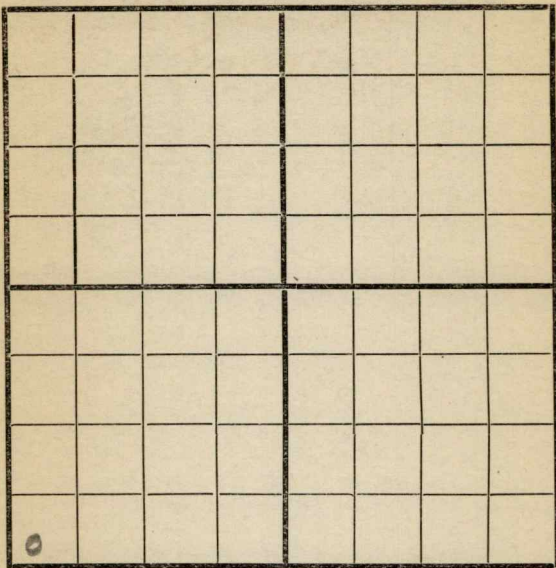

SOUTH

Location _____
 Rig Up ☒ _____
 Drilling and remarks _____

RECORD

Cased _____ in. _____ Ft.
 Sand _____
 Gas _____
 Oil _____
 Total Depth _____

PRODUCTION

1st 24 hrs. Nat. _____
 1st 24 hrs. after shot _____
 Gas _____ Cu. Ft.
 Dry Hole _____
 Abandoned _____

Date


APR 26 1917

191

Carly

Scout

Map No. _____ Sec. 31 Twp. 25 R. 5
Well No. 32 Robinson Farm _____
Empu Company _____
NORTH

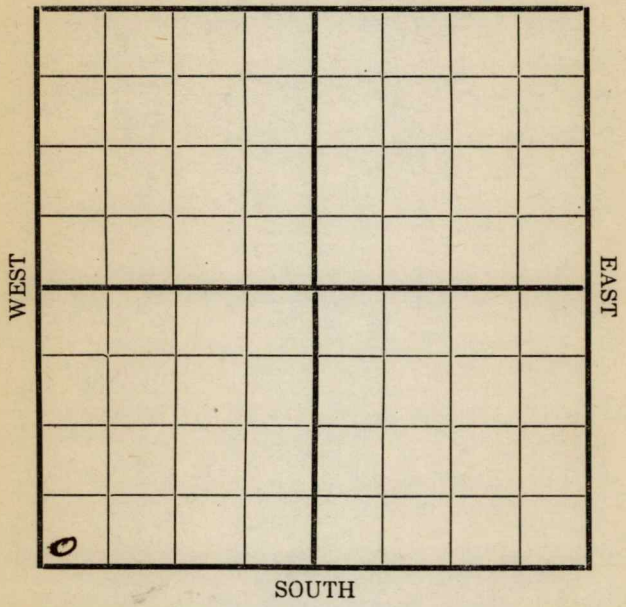

Location _____
Rig Up _____
Drilling and remarks
Rig.

RECORD
Cased _____ in. _____ Ft.
Sand _____
Gas _____
Oil _____
Total Depth _____

PRODUCTION
1st 24 hrs. Nat. _____
1st 24 hrs. after shot _____
Gas _____ Cu. Ft.
Dry Hole _____
Abandoned _____

Date 5/5, 1917 Crocker Scout

Map No. _____ Sec. 31 Twp. 25 R. 5
 Well No. 32 Robinson Farm _____
Emp. Company _____
 NORTH

WEST EAST

SOUTH

Location _____
 Rig up _____
 Drilling and remarks:

Rig

RECORD

Cased _____ in. _____ Ft.
 Sand _____
 Gas _____
 Oil _____
 Total Depth _____

PRODUCTION

1st 24 hrs. Nat. _____
 1st 24 hrs. after shot _____
 Gas _____ Cu. Ft.
 Dry Hole _____
 Abandoned _____

Date _____
5/12, 1917, Crocker Scout

Map No. _____ Sec. 31 Twp. 25 R. 5
 Well No. 32 Robinson Farm _____
E m p. Company _____
 NORTH

WEST EAST

SOUTH

Location _____

Rig up _____

Drilling and remarks:

Rig

RECORD

Cased _____ in. _____ Ft.

Sand _____

Gas _____

Oil _____

Total Depth _____

PRODUCTION

1st 24 hrs. Nat. _____

1st 24 hrs. after shot _____

Gas _____ Cu. Ft.

Dry Hole _____


Abandoned _____

Date

5/19, 1917, Crocker Scout

Map No. _____ Sec. 31 Twp. 25 R. 5Well No. 32 Robinson FarmCompany Emp.

NORTH

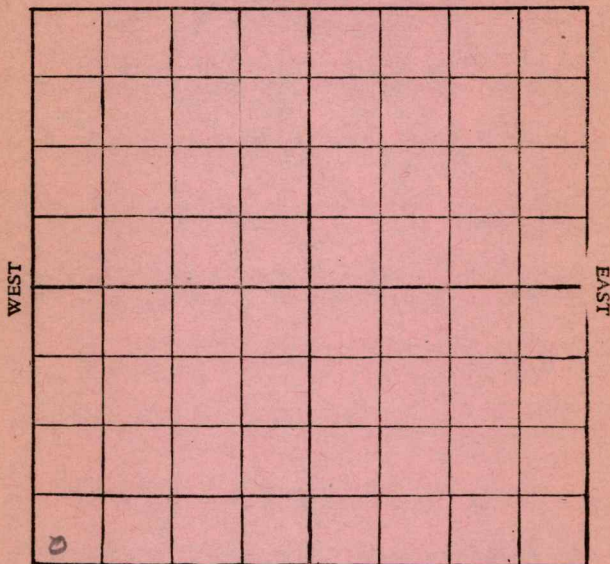

SOUTH

Location _____

Rig up _____

Drilling and remarks:

Rig,

RECORD

Cased _____ in. _____ Ft.

Sand _____

Gas _____

Oil _____

Total Depth _____

PRODUCTION

1st 24 hrs. Nat. _____

1st 24 hrs. after shot _____

Gas _____ Cu. Ft.

Dry Hole _____


Abandoned _____

Date

3/26/1917, Procker Scout

Map No. _____ Sec. 31 Twp. 25 R. 5Well No. 32 Robinson Farm_____Emph_____
Company

NORTH

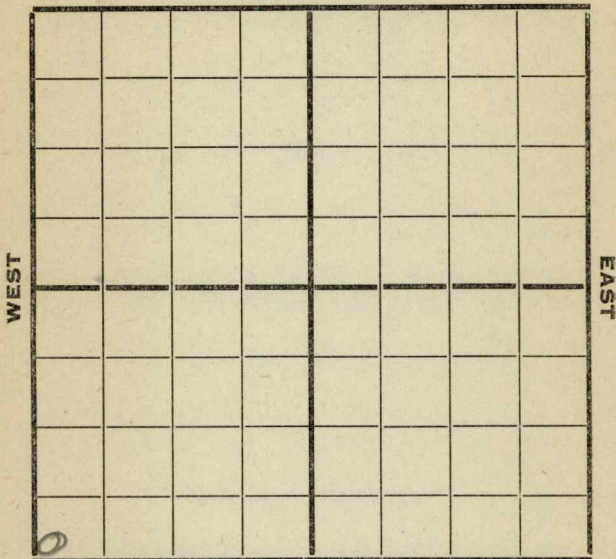

SOUTH

Location _____

Rig up _____

Drilling and Remarks:

Spud

RECORD

Cased _____ in. _____ Ft.

Sand _____

Gas _____

Oil _____

Total Depth _____

PRODUCTION

1st 24 hrs. Nat. _____

1st 24 hrs. after shot _____

Gas _____ Cu. Ft.


Dry Hole _____

Abandoned _____

Date

6/2, 1917, C. T. Crocker Scout.

Map No. _____ Sec. 31 Twp. 25 R. 5
Well No. 32 Robinson Farm _____
Emp. Company _____
NORTH

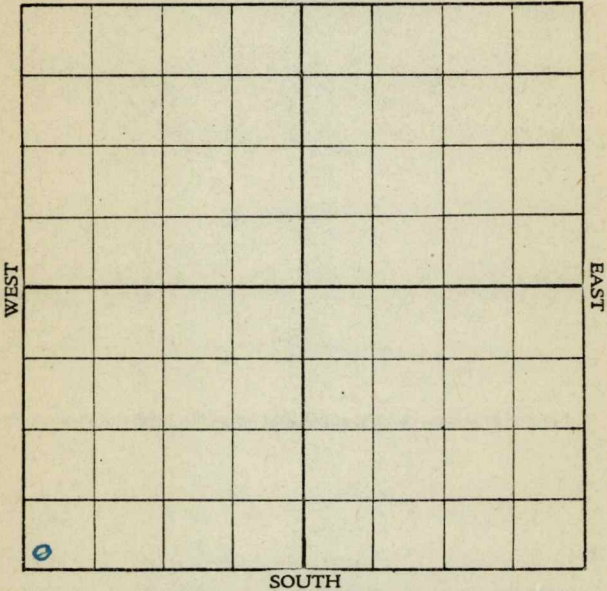

Location _____
Rig up _____
Drilling and remarks:

D-68d

RECORD

Cased _____ in. _____ Ft.
Sand _____
Gas _____
Oil _____
Total Depth _____

PRODUCTION

1st 24 hrs. Nat. _____
1st 24 hrs. after shot _____
Gas _____ Cu. Ft.
Dry Hole _____
Abandoned _____


Date

JUN 16 1917

E. J. Crocker Scout

Map No. _____ Sec. 31 Twp. 25 R. 5Well No. 32 Robinson Farm __________
Emp Company

NORTH

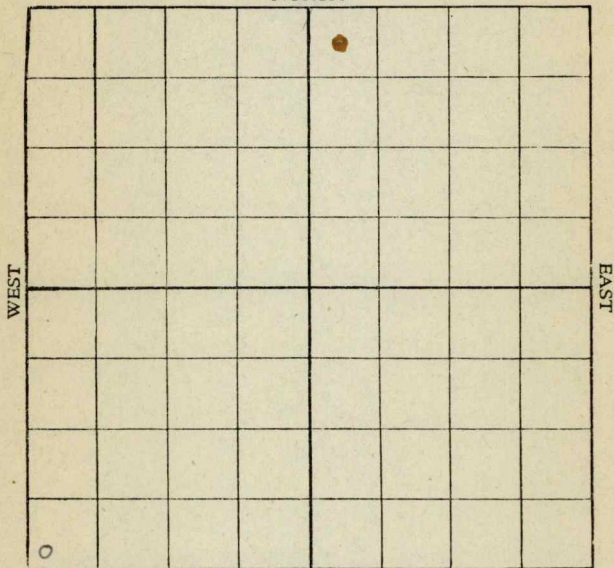

SOUTH

Location _____

Rig up _____

Drilling and remarks:

D-1034

RECORD

Cased _____ in. _____ Ft.

Sand _____

Gas _____

Oil _____

Total Depth _____

PRODUCTION

1st 24 hrs. Nat. _____

1st 24 hrs. after shot _____

Gas _____ Cu. Ft.

Dry Hole _____

Abandoned _____

Date

JUN 22 1917

, 191


G. T. Crocker Scout

Map No. _____ Sec. 31 Twp. 25 R. 5
 Well No. 32 Robinson Farm _____
Empire Company

NORTH

WEST

EAST

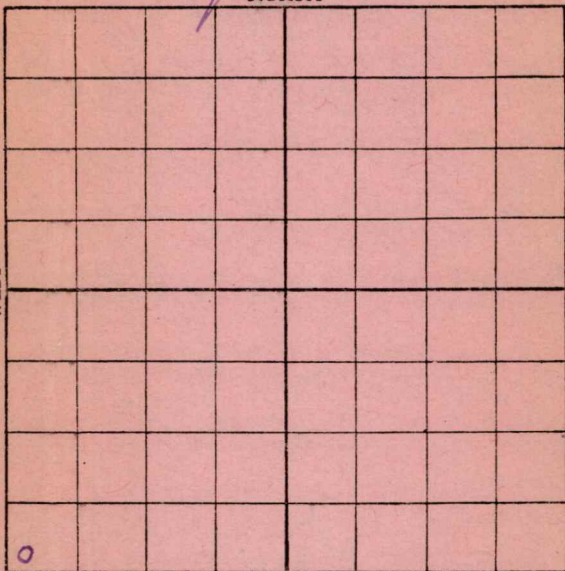

SOUTH

Location _____

Rig up _____

Drilling and remarks:

D-1584'

RECORD

Cased _____ in. _____ Ft.

Sand _____

Gas _____

Oil _____

Total Depth _____

PRODUCTION

1st 24 hrs. Nat. _____

1st 24 hrs. after shot _____

Gas _____ Cu. Ft.

Dry Hole _____

Abandoned _____

Date JUN 30 1917

191

Scout

E. J. Crocker

Map No. _____ Sec. 31 Twp. 25 R. 5
Well No. 32 Robinson Farm _____
Emp Company _____
NORTH

WEST								EAST
SOUTH								

Location _____	RECORD
Rig up _____	Cased _____ in. _____ Ft.
Drilling and remarks: <u>D-2185'</u>	Sand _____
	Gas _____
	Oil _____
	Total Depth _____
	PRODUCTION
	1st 24 hrs. Nat. _____
	1st 24 hrs. after shot _____
	Gas _____ Cu. Ft.
	Dry Hole _____
	Abandoned _____

Date JUL 7 1917 C. T. Crocker Scout

Map No. _____ Sec. 31 Twp. 25 R. 5Well No. 32 Robinson Farm_____
Empire Company

NORTH

WEST

EAST

SOUTH

Location _____

Rig up _____

Drilling and remarks:

PD-2486SD-24882000' oil in
hole - Pulling
10" casing

RECORD

Cased _____ in. _____ Ft.

Sand _____

Gas _____

Oil _____

Total Depth _____

PRODUCTION

1st 24 hrs. Nat. _____

1st 24 hrs. after shot _____

Gas _____ Cu. Ft.

Dry Hole _____

Abandoned _____


Date

JUL 14 1917G. J. Crocker
Scout

Map No. _____ Sec. 31 Twp. 25 R. 5Well No. 32 Robinson FarmEmpire Company

NORTH

WEST

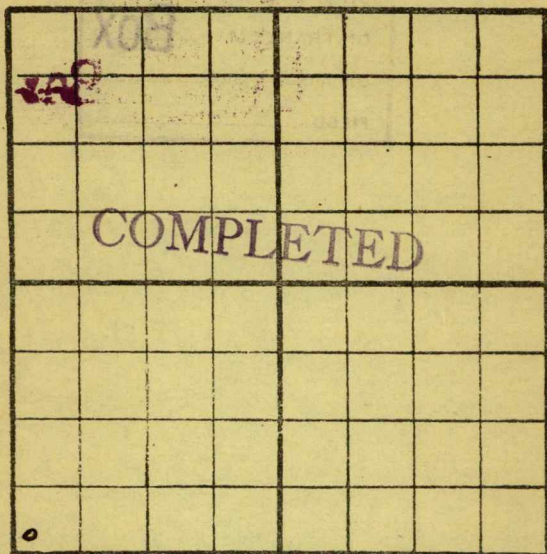

EAST

SOUTH

Location _____

Rig up _____

Drilling and remarks:

RECORD

Cased _____ in. _____ Ft.

Sand 2486-2498

Gas _____

Oil _____

Total Depth _____

PRODUCTION

1st. 24 hrs. Nat. _____

1st. 24 hrs. after shot. _____

Gas _____ Cu. Ft.

Dry Hole _____

Abandoned _____

Date

7/27 1917 Candif Scout