


Texas Co.

STATE Kansas		COMPANY C.S.O.	
COUNTY Phillips		FARM Reese "E" #2	
T. 5s	R. 20w	WELL NO. #2	
SURVEY		DIVISION	DISTRICT
		KIND OF RIG	
		COMMENCED 11-11-42	
		COMPLETED 11-21-42	
		REMARKS SW NE SE 990'S & W of E/4 cor. Ran Sch. 1/4	
ELEV. 2171			
PRODUCTION 1689 BBL			

CASING AND SCREEN RECORD

10 3/4" — 160'
7" — 369'

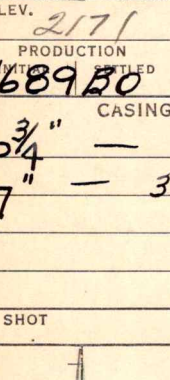