


Map No. Kansas Sec. 27 Twp. 22 R. 13

Well No. 1 Miller Farm

Braden Bros Company

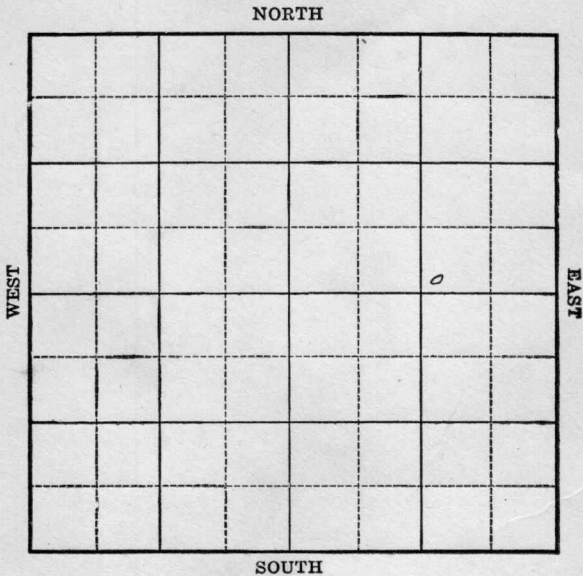

Location _____

Drilling Remarks:

RECORD

Cased _____ in. _____ ft.

Sand _____

Gas _____

Oil _____

Total Depth _____

Rig Up _____

Drilling Remarks:

PRODUCTION

1st 24 hrs. Nat. _____

1st 24 hrs. after shot _____

Gas _____ cu. ft.

Dry Hole _____

Abandoned _____

Map No. Kanawha Sec. 27 Twp. 22 R. 13

Well No. 1 Miller Farm


Braden Bros Company

Ft. from N. Line

250 Ft. from S. Line

1120 Ft. from E. Line

Ft. from W. Line

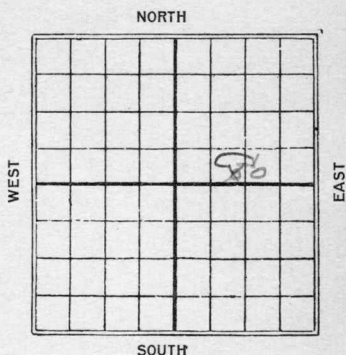[illegible]

Map No. *Km A* Sec. *27* Twp. *22* R. *13*Well No. *1* *Miller*
Braden Bros. Company

Contractor

FIRST REPORTS

Ft. from N. Line

750 Ft. from S. Line

Ft. from E. Line

1120 Ft. from W. Line

SECTION PLAT

Location

Rig up

Drilling and Remarks:

Requing up.

RECORD

Cased _____ in., _____ ft.

Sand _____

Gas _____

Oil _____

Total Depth _____

PRODUCTION

1st 24 hrs. Nat. _____

1st 24 hrs. after shot _____

Gas _____ Cu. Ft.

Dry Hole _____

Abandoned _____

Date

APR 17 1925

192

Chas. L. Hammond
Scout

Map No. *1440* Sec. *27* Twp. *22* R. *13*Well No. *1 Miller*
Braden Bros Company

Contractor

CORRECTION

SECTION PLAT

Ft. from N. Line

250 Ft. from S. Line*1120* Ft. from E. Line

Ft. from W. Line

		<i>68</i>	

1st Report

Location

Rig up

Drilling and Remarks:

Rigging up

CORRECTION

chg location

RECORD

Cased _____ in., _____ ft.

Sand _____

Gas _____

Oil _____

Total Depth _____

PRODUCTION

1st 24 hrs. Nat. _____

1st 24 hrs. after shot _____

Gas _____ Cu. Ft.

Dry Hole _____

Abandoned _____

Date
APR 24 1925

192

Chas L. Sherwood Scout

Map No. Kenda Sec. 27 Twp. 22 R. 13

Well No. 1 Miller

Braden Bros Company

Contractor

SECTION PLAT

_____ Ft. from N. Line

750 Ft. from S. Line

1120 Ft. from E. Line

_____ Ft. from W. Line

COMPLETED

Location _____

Rig up _____

Drilling and Remarks:

Tap Run 1840'

50 b/s natural

RECORD

Cased _____ in., _____ ft.

Sand 1832-40'

Gas _____

Oil _____

Total Depth 1864'

PRODUCTION

1st 24 hrs. Nat. _____

1st 24 hrs. after shot _____

Gas _____ Cu. Ft.

Dry Hole _____

Abandoned _____

Date

MAY 8 1925

CHAS. L. SHERWOOD

192 _____ Scout