
Form 51 5M 8-24 16567

Map No. Kansas Sec. 27 Twp. 22 R. 13 E

Well No. 2 Miller Farm

R. G. Gillespie Company

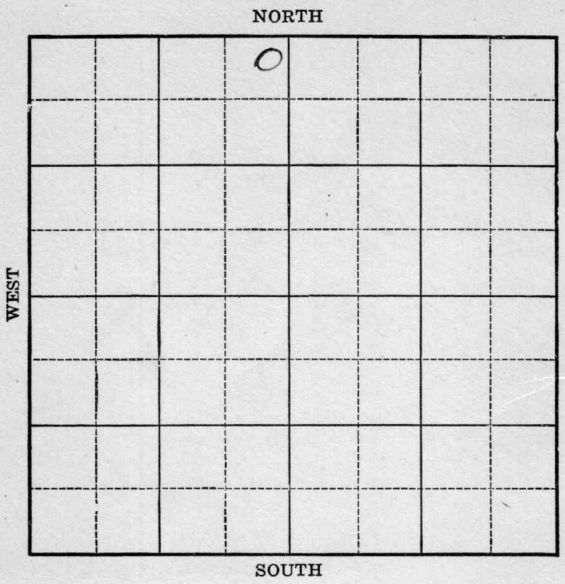


3

Location

Drilling Remarks

Rig Up

Drilling Remarks

RECORD

Cased in. ft.

Sand

Gas

Oil

Total Depth

PRODUCTION

1st 24 hrs. Nat.

1st. 24 hrs. after shot

Gas cu. ft.

Dry Hole

Abandoned

Form 252A 5M 8-24 16529

Map No. Kan. Sec. 27 Twp. 22 R 13

Well No. 2 Miller Farm

R. G. Gillispie Company


300 Ft. from N. Line

Ft. from S. Line

300 Ft. from E. Line

Ft. from W. Line

C

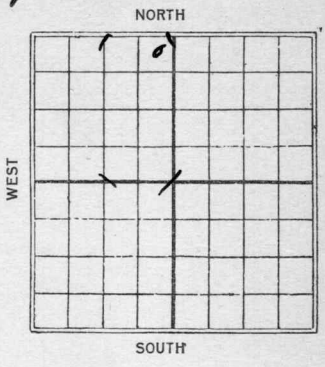


| Date 1925 | REPORT |
|---|---|
| 7/3 | Timbers |
| 7/10 | Rig up |
| 7/17 | 480 |
| 7/24 | 1065' |
| 7/31 | 1700' |
| 8/7 | —— |
| 8/14 | —— |
| 8/20 | 1882–1894 30 gts<br>6 Bbls oil 5 Bbls Water |

Form 26—1M Bks.—3-23—11959.

Map No. Kgds Sec. 27 Twp. 22 R. 13

Well No. 2 Miller

K. B. Gillespie Company

Contractor

FIRST REPORTS


300 Ft. from N. Line

Ft. from S. Line

300 Ft. from E. Line

Ft. from W. Line

SECTION PLAT

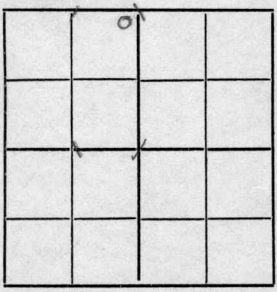

Location

Rig ~~up~~ Lumbers

Drilling and Remarks:

RECORD

Cased in., ft.

Sand

Gas

Oil

Total Depth

PRODUCTION

1st 24 hrs. Nat.

1st 24 hrs. after shot

Gas Cu. Ft.

Dry Hole

Abandoned

Date

JUL 3 1925 CHAS. L. SHERWOOD

192 Scout

Form 26—1M Bks.—3-23—11959. Sherwood Co

Map No. KANSAS Sec. 27 Twp. 22 R. 13


Well No. 2 Miller

R. D. Gillespie Company

Contractor

COMPLETED

SECTION PLAT

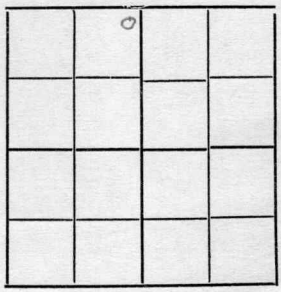

300 Ft. from N. Line

Ft. from S. Line

300 Ft. from E. Line

Ft. from W. Line

Location

Rig up

Drilling and Remarks:

30 bbls oil
5 bbls water.

RECORD

Cased 0 in., 0 ft.

Sand 1882-1894'

Gas

Oil

Total Depth 1894'

PRODUCTION

1st 24 hrs. Nat.

1st 24 hrs. after shot

Gas Cu. Ft.

Dry Hole

Abandoned

Date

AUG 20 1925

192

CHAS. L. SHERWOOD

Scout