

Greenwood

KANSAS

Section 27 Township 22 Range 13 EWell No. # 1 Miller "A"Company Grant Oil Co.

NORTH

				0			

SOUTH


WEST

EAST

7

Sec. 27 Twp. 22 R. 13EWell No. 1 Miller "A" FarmGrant Oil Co. CompanyWhite & Ellis Contractor Ft. from N. Line990 Ft. from S. Line Ft. from E. Line330 Ft. from W. Line

NW SW NE

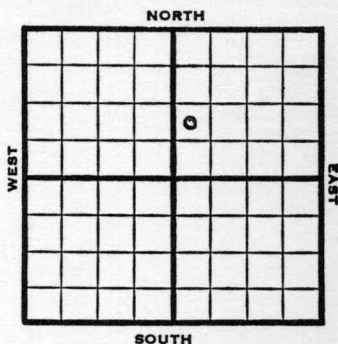

1953

Elev. -

REPORT

4/15
5/20

RUR

Spud 4-19-53

Oil Well

TD 1878'

10" @ 105'

Lans 785', KC 1150, Burgess 1840

TD 1844'

7" @ 1841'

Miss 1846

DD 1878, FU 300' oil 16 hr.

Comp. 10 bopd.

COMPLETED

County **Greenwood** State **Kansas**

Sec. **27** (Blk.) **22** (Sur.) **13E** Map No.

Operator Grant Oil Co.

Well No. **1** Farm **Miller "A"**

Elev.	Location	NW	SW	NE
-------	----------	----	----	----

990 Ft. From S Line NE

330 Ft. From W Line Quarter

1st. Report APR 15 1953

Completion

Remarks

White & Ellis - Contr.

Spudding Date _____

Drlg. Data

R U R

J. G. McGEHEE

