

Map No. _____ Sec. 28 Twp. 22 R. 13
Well No. 1 Barnard Farm _____
R. J. Gillespie Company _____

NORTH

WEST

EAST

SOUTH

Location _____

Drilling Remarks:

Rig up _____

Drilling Remarks:

RECORD

Cased _____ in. _____ ft.

Sand _____

Gas _____

Oil _____

Total Depth_____

PRODUCTION

1st 24 hrs Nat. _____

1st 24 hrs. after shot_____

Gas _____ cu. ft.

Dry Hole _____

Abandoned _____

Map No. _____ Sec. 28 Twp. 22 R. 13

Well No. 1 Barnard Farm


R. M. Gillespie Company

Ft. from N, Line

200 Ft. from S. Line

200 Ft. from E. Line

Ft. from W. Line

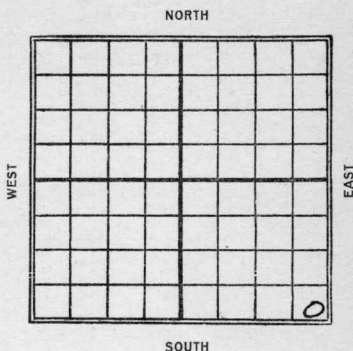

Date
1923

REPORT

3/2 Rig.
4/30 Jopline 1860 - Pay
1887 - 1900 - Shot 60
lbs. 50 lbs.

Map No. **KANSAS** *Mo Map* Sec. *28* Twp. *22* R. *13*Well No. *R. S. Barnard**R. S. Gillespie* Company

Contractor

FIRST REPORT

SECTION PLAT

Ft. from N. Line

200 Ft. from S. Line*200* Ft. from E. Line

Ft. from W. Line

			0

Location

Rig up *2 ✓*

Drilling and Remarks:

RECORD

Cased _____ in., _____ ft.

Sand _____

Gas _____

Oil _____

Total Depth _____

PRODUCTION

1st 24 hrs. Nat. _____

1st 24 hrs. after shot _____

Gas _____ Cu. Ft.

Dry Hole _____

Abandoned _____

Date

MAR 2 1923

M. A. BENEAR

_____ 191 _____

Scout

Map No. **KANSAS** Sec. *28* Twp. *22* R. *13*Well No. *10 Barnard*
R. G. Gillespie Company

Contractor

COMPLETED

SECTION PLAT

Ft. from N. Line

200 Ft. from S. Line*200* Ft. from E. Line

Ft. from W. Line

			0

Location

Rig up

Drilling and Remarks:

*Tap Line 1860**Pay 1887-1900 T.D.**60/50*

RECORD

Cased _____ in., _____ ft.

Sand _____

Gas _____

Oil _____

Total Depth _____

PRODUCTION

1st 24 hrs. Nat. _____

1st 24 hrs. after shot _____

Gas _____ Cu. Ft.

Dry Hole _____

Abandoned _____

Date

APR 20 1923

E. A. BENEAR

191

Scout