


Map No. 114 Sec. 1 Twp. 26 R. 4Well No. 51 Porter
Counter Company

Contractor

NORTH

WEST

EAST

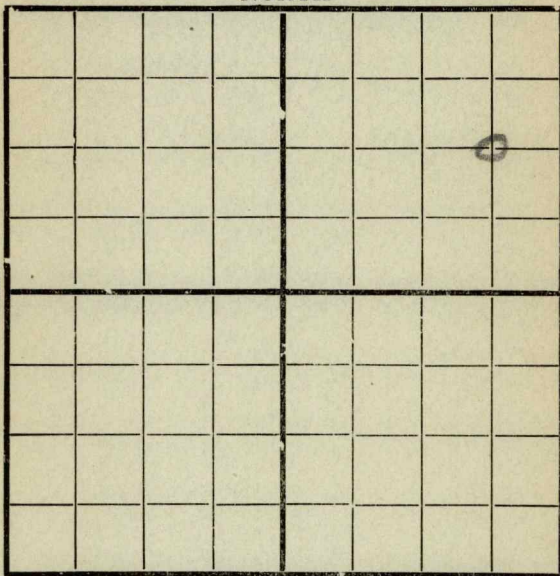

1320 N 660 E SOUTH

Location _____

Rig up _____

Drilling and Remarks:

970

RECORD

Cased _____ in., _____ ft.

Sand _____

Gas _____

Oil _____

Total Depth _____

PRODUCTION

1st 24 hrs. Nat. _____

1st 24 hrs. after shot _____

Gas _____ Cu. Ft.

Dry Hole _____

Abandoned _____

Date

12/4 191 8 Candy Scout