


Map No. 11 Sec. 28 Twp. 22 R. 19

Well No. 1 *Barnard* Farm

Callahan & Winsworth Company

NORTH

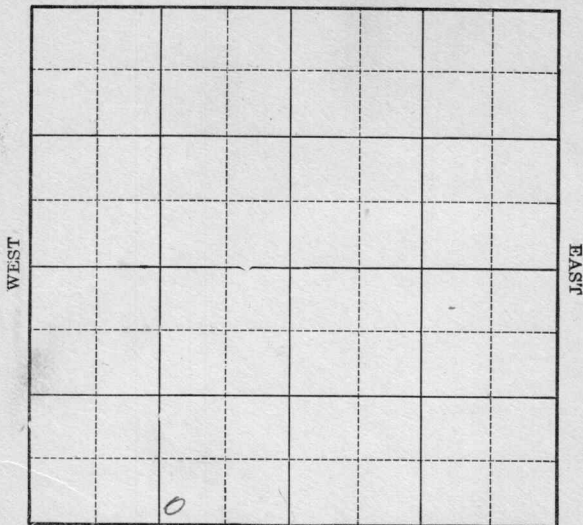

SOUTH

Location _____

Drilling Remarks

Rig Up

Drilling Remarks

RECORD

Cased_____in. _____ft.

Sand

Gas

Oil

Total Depth _____

PRODUCTION

1st 24 hrs. Nat.

1st 24 hrs. after shot -----

Gas _____ cu. ft.

Dry Hole_____

Abandoned

Greenwood


Map No. Kansas Sec. 28 Twp. 22 R. 13Well No. 1 Barnard FarmCallahan & Ainsworth Company

Ft. from N. Line

330 Ft. from S. Line

990 Ft. from E. Line

Ft. from W. Line

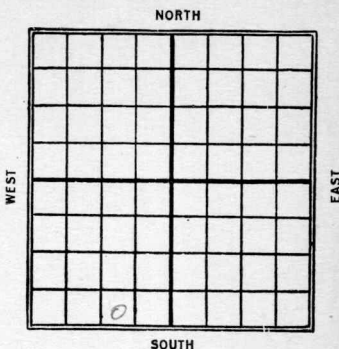


Date

REPORT

1926	
6/2	Location
6/10	—
6/18	—
6/25	—
6-30	—
7/8	—
7/15	Rigging up
7/22	same
7/28	Location only
8/2	—
8/11	—
8/18	same
8/25	—
8-31	machine
9/15	sh. 465
9/22	—
9/29	Dr. 620'
10/3	" 1150'
10/27	Broken sand 1735-1800 top line 1868 - S.D. for 5"
11/10	sand 1871-1886 Bkn. sd. 1735-1800 (over)

Top lime 1868
40/50 bbb

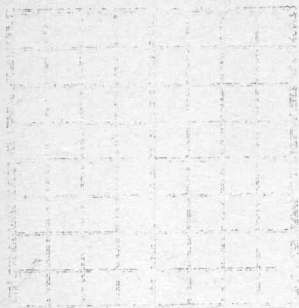

Shenwood
now KANSAS *28* Sec. *22* Twp. *13*
 Map No. _____
 Well No. *1* *Dunnard* _____
Callahan & Linworth Company

 Contractor

FIRST REPORTS

 Ft. from N. Line
330

 Ft. from S. Line
990

 Ft. from E. Line

 Ft. from W. Line

SECTION PLAT

Location *✓* _____

Rig up _____

Drilling and Remarks:

RECORD

Cased _____ in., _____ ft.

Sand _____

Gas _____

Oil _____

Total Depth _____

PRODUCTION

1st 24 hrs. Nat. _____

1st 24 hrs. after shot _____

Gas _____ Cu. Ft.

Dry Hole _____

Abandoned _____

Date

JUN 2 1926

192

CHAS. L. SHERWOOD
 Scout

normal
KANSAS
 Map No. *28* Sec. *22* Twp. *13*
 Well No. *1* *Barnes*
Callahan & Ainsworth Company

Contractor

COMPLETED

SECTION PLAT

	0		

Ft. from N. Line

330

Ft. from S. Line

990

Ft. from E. Line

Ft. from W. Line

Location

Rig up

Drilling and Remarks:

Drill 88 1735-1800
+ 1868'

40
50 Bl.

RECORD

Cased *1875* in., *1886* ft.Sand *1875* *1886*

Gas

Oil

Total Depth *1886'*

PRODUCTION

1st 24 hrs. Nat.

1st 24 hrs. after shot

Gas Cu. Ft.

Dry Hole

Abandoned

Date

NOV 11 1926

CHAS. L. SHERWOOD

192

Scout