
FORM 51 25M 3-49 PETROL Greenwood KANSAS

Section 28 Township 22 Range 13 E

Well No. # 1 Imthurn

Company W. E. Ellis

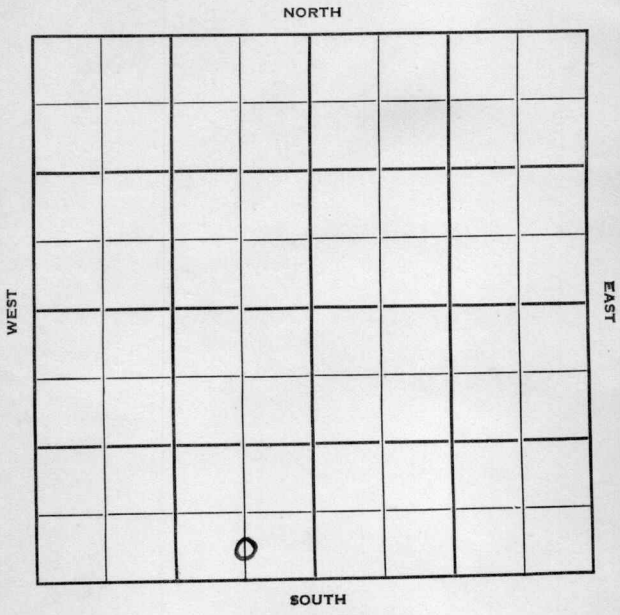

FORM 252-B
10M 8-51 TPCO.

Greenwood

KANSAS ✓

Sec. 28 Twp. 22 R. 13E

Well No. #1 Imthurn Farm

W. E. Ellis Company

White & Ellis Contractor


Ft. from N. Line

330 Ft. from S. Line

660 Ft. from E. Line

Ft. from W. Line

C S/2 SE SW

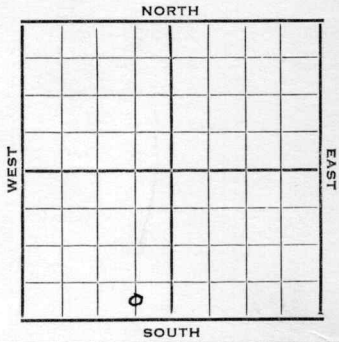

1952	Elev. - REPORT
5/21	Miss. 1859' Drlg. 1887'
6/18	Oil Well TD 1910 Miss 1859 TD 1910 5" @ 1860 CO to 1910 500 A Comp. 7 bopd COMPLETED

FORM 275 FOR SALE BY KANSAS BLUE PRINT CO.


County Greenwood State Kansas

Sec. 28 (Blk. Twp.) 22 (Sur. Rge.) 13E Map No.

Operator W.E.Ellis

Well No. 1 Farm Imthurn

Elev. Location C S/2 SE SW

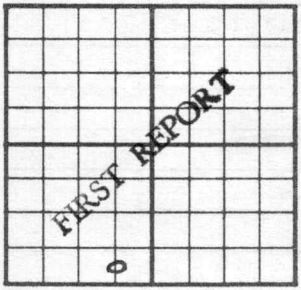

330 Ft. From S Line SW

660 Ft. From E Line Quarter

1st. Report MAY 21 1952

Completion

Remarks

White & Ellis - Contr.

Spudding Date

Drlg. Data

Miss 1859 Dlr.g 1887

J. G. McGEHEE

FORM 275 FOR SALE BY KANSAS BLUE PRINT CO.


County Greenwood State Kansas

Sec. 28 (Blk. Twp.) 22 (Sur. Rge.) 13E Map No.

Operator W. E. Ellis

Well No. 1 Farm Imthurn

Elev. Location C S L SE SW

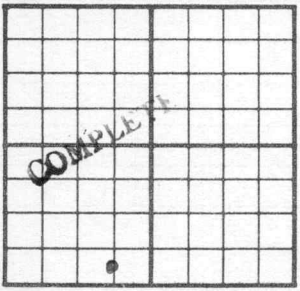

330 Ft. From S Line SW

660 Ft. From E Line Quarter

1st. Report

Completion JUN 1 8 1952

Remarks

White & Ellis - Contr.

Spudding Date

Drlg. Data Oil well TD 1910

Miss. 1859 TD 1910 5" @ 1860

CO to 1910 500 A Comp. 7 bopd

J. G. McGEHEE