
Greenwood

FORM 51-5M-6-29-PETROL

Map No. KANSAS Sec. 29 Twp. 22 R. 13E

Well No. 2 Blank Farm

Fore & Phillips Company

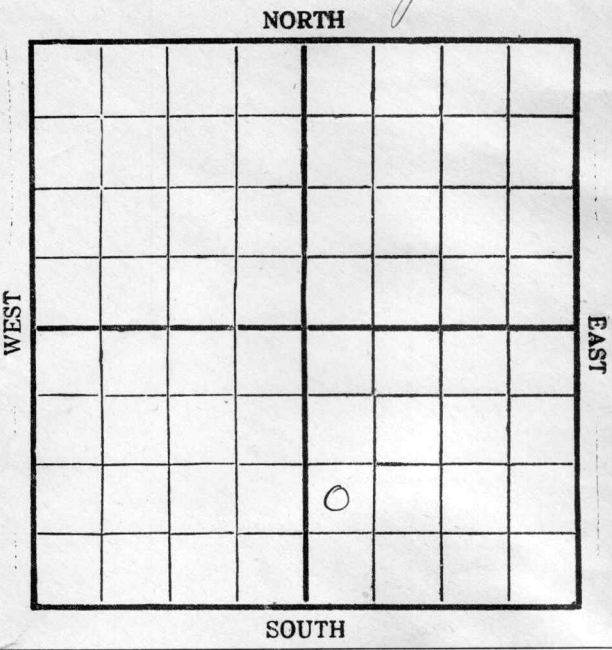

Location _____

Drilling Remarks

Rig Up _____

Drilling Remarks

RECORD

Cased _____ in. _____ ft.

Sand _____

Gas _____

Oil _____

Total Depth _____

PRODUCTION

1st 24 hrs. Nat. _____

1st 24 hrs. after shot _____

Gas _____ cu. ft. _____

Dry Hole _____

Abandoned _____

Form 252A—5M—11-29—38055

Greenwood

Map No. KANSAS Sec. 29 Twp. 22 R. 13E

Well No. 2 Blank Farm

Sore & Phillips Company

NORTH

WEST EAST

SOUTH

Ft. from N. Line

940 Ft. from S. Line

Ft. from E. Line

330 Ft. from W. Line

1930

Date	REPORT
2/19	Machine
2/26	Spdg.
3/5	Drlg. 1013.
3/12	Sand 1688-1714-
	Shot 100 qts, 350'
	oil—Sdg. out.
3/19	Sand 1688-1714
	T.D. 1714
	Shot 100 qt
	70 bbl oil
	Comp.

Form 26—1M Bks. 9-28

Greenwood

Map No. KANSAS Sec. 29 Twp. 22 R. 13 E

20


Well No. 2 Blank

Gore & Phillips Company

Contractor

FIRST REPORTS

SECTION PLAT

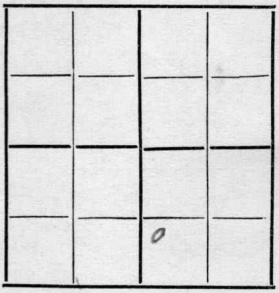

Ft. from N. Line

990 Ft. from S. Line

Ft. from E. Line

330 Ft. from W. Line

Location

Rig up

Drilling and Remarks:

Mocking

RECORD

Cased in., ft.

Sand

Gas

Oil

Total Depth

PRODUCTION

1st 24 hrs. Nat.

1st 24 hrs. after shot

Gas Cu. Ft.

Dry Hole

Abandoned

Date

FEB 19 1930 CHAS. L. SHERWOOD

192 Scout

Form 26—1M Bks.—9-26

Greenwood

20 KANSAS

Map No. ..... Sec. 29 Twp. 22 R. 13


Well No. 2 Blank

Gore & Phillips ..... Company

..... Contractor

COMPLETE

SECTION PLAT

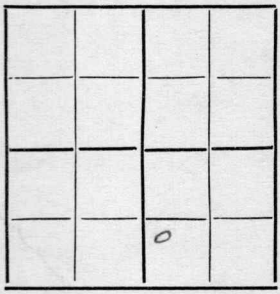

9 ..... Ft. from N. Line

990 ..... Ft. from S. Line

..... Ft. from E. Line

330 ..... Ft. from W. Line

Location .....

Rig up .....

Drilling and Remarks:

100/70 Bls.

RECORD

Cased ..... in., ... ft.

Sand 1688-1714

Gas .....

Oil .....

Total Depth 1714

PRODUCTION

1st 24 hrs. Nat. .....

1st 24 hrs. after shot .....

Gas ..... Cu. Ft.

Dry Hole .....

Abandoned .....

Date

MAR 19 1930

192 ..... CHAS. L. SHERWOOD

..... Scout